

ALL INFORMATION SHOWN ON THIS DRAWING MUST BE VERIFIED AGAINST THE RESULTS OF A SITE SURVEY AND EXISTING AS-BUILT INFORMATION PRIOR TO THE START OF ANY PRELIMINARY FABRICATION OR CONSTRUCTION. ANY VARIATIONS FROM AS-BUILT INFORMATION AND SITE SURVEY MUST BE REPORTED TO THE PROJECT MANAGER AND THEIR APPROVAL MUST BE OBTAINED PRIOR TO COMMENCEMENT OF ANY FABRICATION OR CONSTRUCTION WORKS.

Copyright Capita Limited. This document is the property of Capita Limited. It is not to be used for any other purpose without the prior written consent of Capita Limited. Capita Limited is not responsible for any errors or omissions in this document. The information contained herein is for reference only and should not be used as a basis for any design or construction. The information contained herein is for reference only and should not be used as a basis for any design or construction.

Notes:
 1. For legend symbols refer to drawing number 077719-LCI-SPK-CH-DSO-0131



Building, Health and Environmental Information
 A review of the Building Health and Safety (BHS) report indicates that there are no known or suspected asbestos, lead, or other contaminants in the area. The site is located in an area of high ground water and is adjacent to the Docklands Light Railway.

Item	Status	Date
1.01 Additional ground investigation	Not Started	17/12/14
1.02 Ground investigation	Not Started	17/12/14
1.03 Approved to start construction	Not Started	17/12/14
1.04 Approved to start construction	Not Started	17/12/14
1.05 Approved to start construction	Not Started	17/12/14
1.06 Approved to start construction	Not Started	17/12/14

For Construction A

Commercial in Confidence

Use
 Docklands Light Railway

Phase
 South Park Landscaping Works

Location
 Olympic South Park Infrastructure Setting Out Details General Arrangement


Scale	Drawn	Checked	Approved
1:500			

Project No.
 CS077719

Date
 17/12/14

Drawing No.
 077719-LCI-SPK-CH-DSO-0131 C02

CAPITA
 Property and Infrastructure

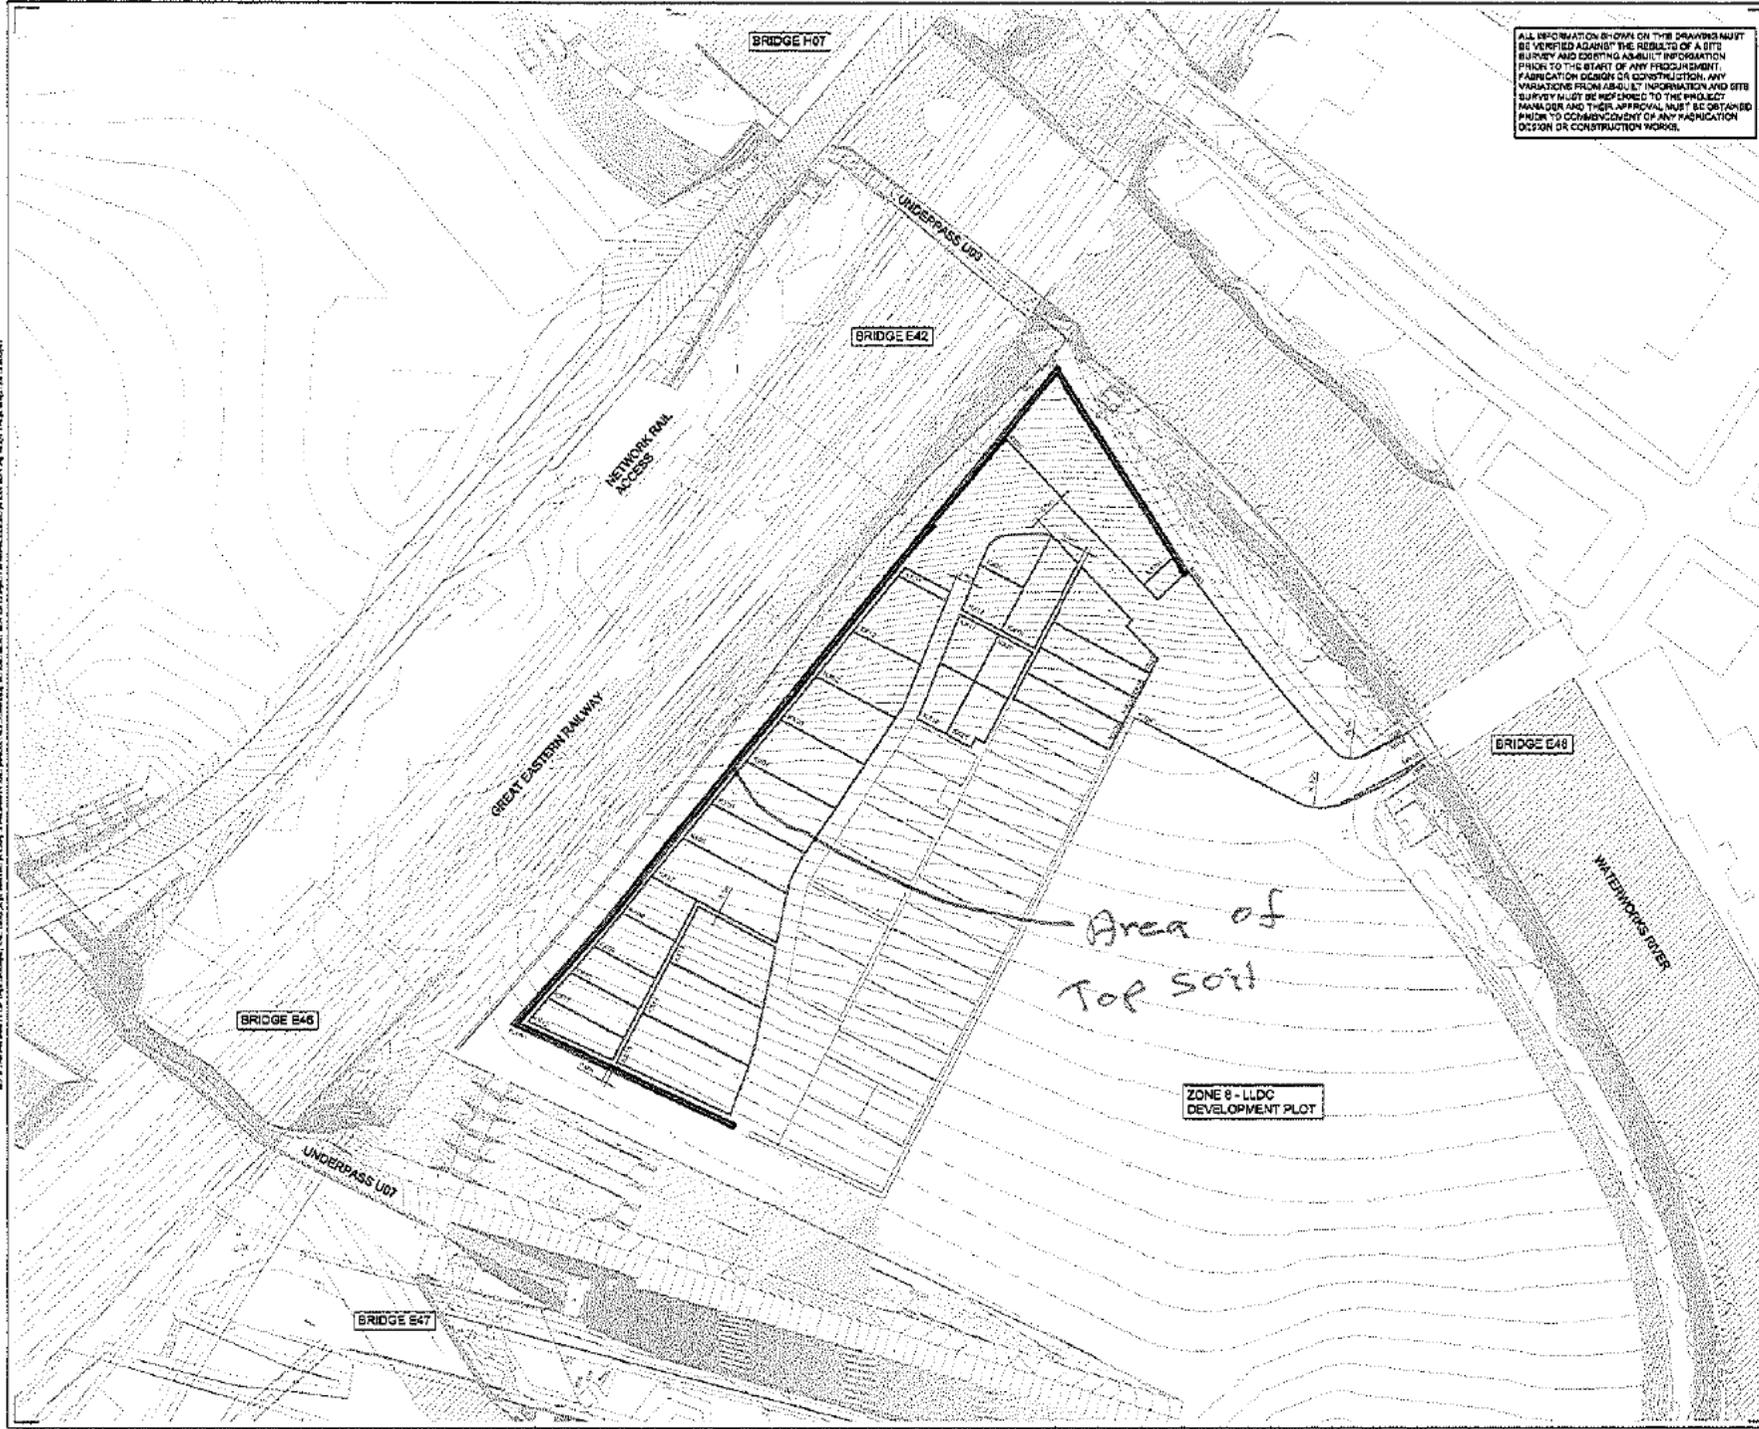

077719-LCI-SPK-CH-DSO-0131 C02
 17/12/14
 1:500
 CS077719
 077719-LCI-SPK-CH-DSO-0131 C02
 CAPITA
 Property and Infrastructure