

NOTE:
ARRANGEMENT SHOWN PRODUCED FOR ILLUSTRATION/QUOTATION PURPOSES ONLY.
(THIS ARRANGEMENT HAS NOT BEEN ENGINEERED AND IS THUS SUBJECT TO POSSIBLE CHANGES)




ES Global Ltd.
Unit G East, Coate House, 1-3 Coate Street, London E2 9AG
T: +44 (0)20 7055 7200 F: +44 (0)20 7055 7201
E: info@esglobalsolutions.com
W: esglobalsolutions.com

1. This drawing is copyright and the property of ES Global Ltd. It must not be copied or used, in part or whole, without the written consent of ES Global Ltd. Failure to do so may lead to legal proceedings under the Copyright, Design and Patents Act 1988.
2. The information shown on this drawing is based upon information supplied to ES Global Ltd. by the client.
3. It is the responsibility of the client to:
(i) check that their requirements have been correctly interpreted
(ii) confirm the accuracy and the validity of the drawing supports in writing to the issuing office ES Global Ltd.
4. Any modification to the details shown on this drawing MUST be referred to ES Global Ltd. for their information and approval.
5. All dimensions in MILLIMETRES - unless stated otherwise.
6. Scale NOT to be taken from this drawing. Work will be based on dimensions.

NOTES

- GENERAL ADMISSION SEATING
4698x TOTAL
- MAIN HOSPITALITY SEATING
1522x TOTAL
- PREMIUM GA SEATING
610x TOTAL
- GA + HOSPITALITY SEATING
6830x
- DUGOUT SEATING
102x TOTAL
- DISABLED SEATING
148x TOTAL
- OVERALL TOTAL SEATING
7080x**

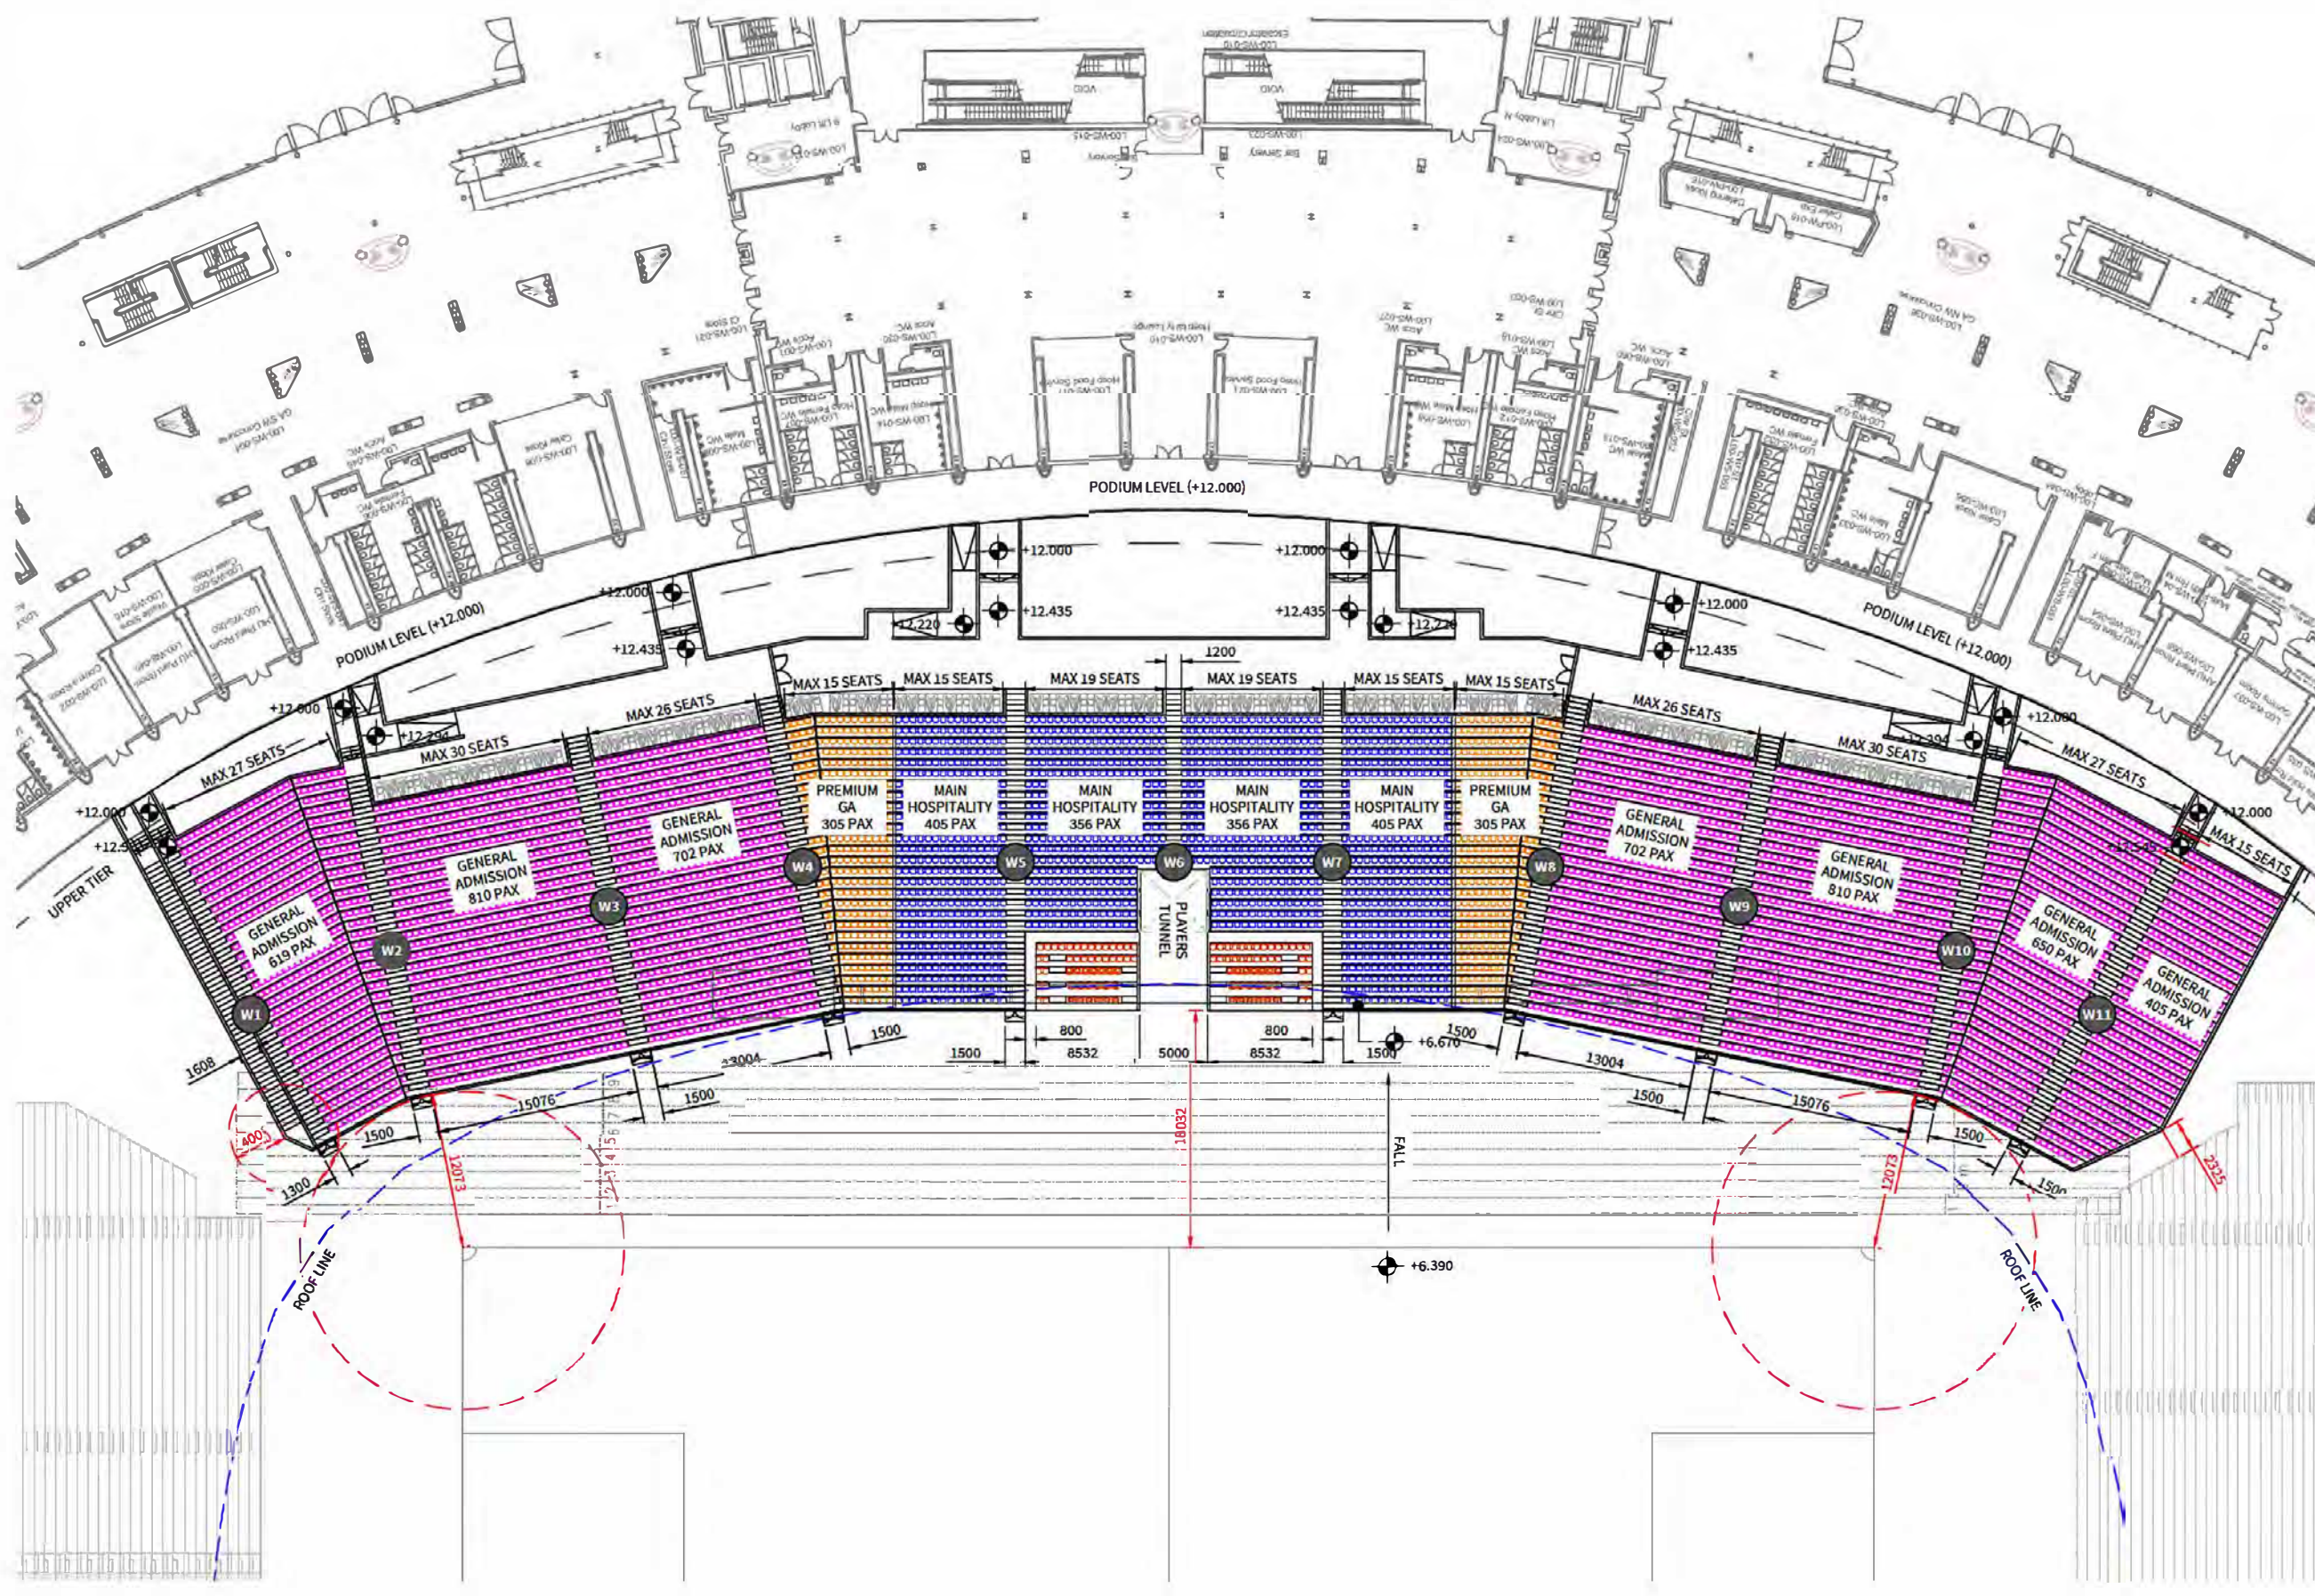

REV	DESCRIPTION	DRAWN	CHKD	DATE
P11	SEATING CAPACITY REVISED	RK	TO	01.02.21
P10	UPDATED FOR STAGE 3 SUBMISSION	RK	TO	24.01.21
P09	SEATING CAPACITIES REVISED	RK	TO	11.01.21
P08	RAMP & GATES REVISED	RK	TO	07.01.21
P07	SEATING CAPACITY REVISED	RK	TO	06.01.21
P06	DUGOUT FOOTPRINT REVISED	TO	JT	23.12.20
P05	HOSPITALITY SEATING REVISED	TO	JT	22.12.20
P04	DUGOUT OPTION C ADDED & CLADDING DETAILS ADDED TO PAGE 3	TO	JT	22.12.20
P03	SEATING CAPACITIES REVISED	TO	JT	14.12.20
P02	SEATING CAPACITIES INCREASED	TO	JT	13.12.20
P01	FIRST ISSUE	TO	JT	02.12.20

For information relating to Use, Cleaning and Maintenance see the Health and Safety File. It is assumed that all works will be carried out by a competent contractor working, where appropriate, to an approved method statement.

CLIENT
PREPARED BY ESG GLOBAL ON BEHALF OF E20 STADIUM LLP

PROJECT TITLE
WEST STAND REPLACEMENT
LONDON STADIUM

DRAWING TITLE
STRUCTURE - FOOTBALL CONFIGURATION
GENERAL ARRANGEMENT

DATE	SCALE	PAPER SIZE	SUITABILITY
08.12.21	1:500	A3	S4

ISSUE STATUS
APPROVAL
NOT TO BE USED FOR CONSTRUCTION

APPROVED BY
TO

DRAWING NO
A2333-ESG-00-B1-GA-W-0100-P11_1

REVISION
P11


NOTE:
ARRANGEMENT SHOWN PRODUCED FOR ILLUSTRATION/QUOTATION PURPOSES ONLY.
(THIS ARRANGEMENT HAS NOT BEEN ENGINEERED AND IS THUS SUBJECT TO POSSIBLE CHANGES)



ES Global Ltd.
Unit G East, Coate House, 1-3 Coate Street, London E2 9AG
T. +44 (0)20 7055 7200 F. +44 (0)20 7055 7201
E. info@esglobalsolutions.com
W. esglobalsolutions.com

1. This drawing is copyright and the property of ES Global Ltd. It must not be copied or used, in part or whole, without their written consent. Failure to do so may lead to legal proceedings under the copyright, Design and Patent Act 1988.
2. The information shown on this drawing is based upon information supplied to ES Global Ltd. by the client. It is the responsibility of the client to:
(i) check that their requirements have been correctly interpreted
(ii) confirm the accuracy and the validity of the drawing contents in writing to the issuing office ES Global Ltd.
3. Any modification to the details shown on this drawing MUST be referred to ES Global Ltd. for their information and approval.
4. All dimensions in MILLIMETRES - unless noted otherwise.
5. Do NOT scale from this drawing. Work only to figured dimensions.

- NOTES
- GENERAL ADMISSION SEATING
 - MAIN HOSPITALITY SEATING
 - PREMIUM GA SEATING
 - DUGOUT SEATING
 - DISABLED SEATING

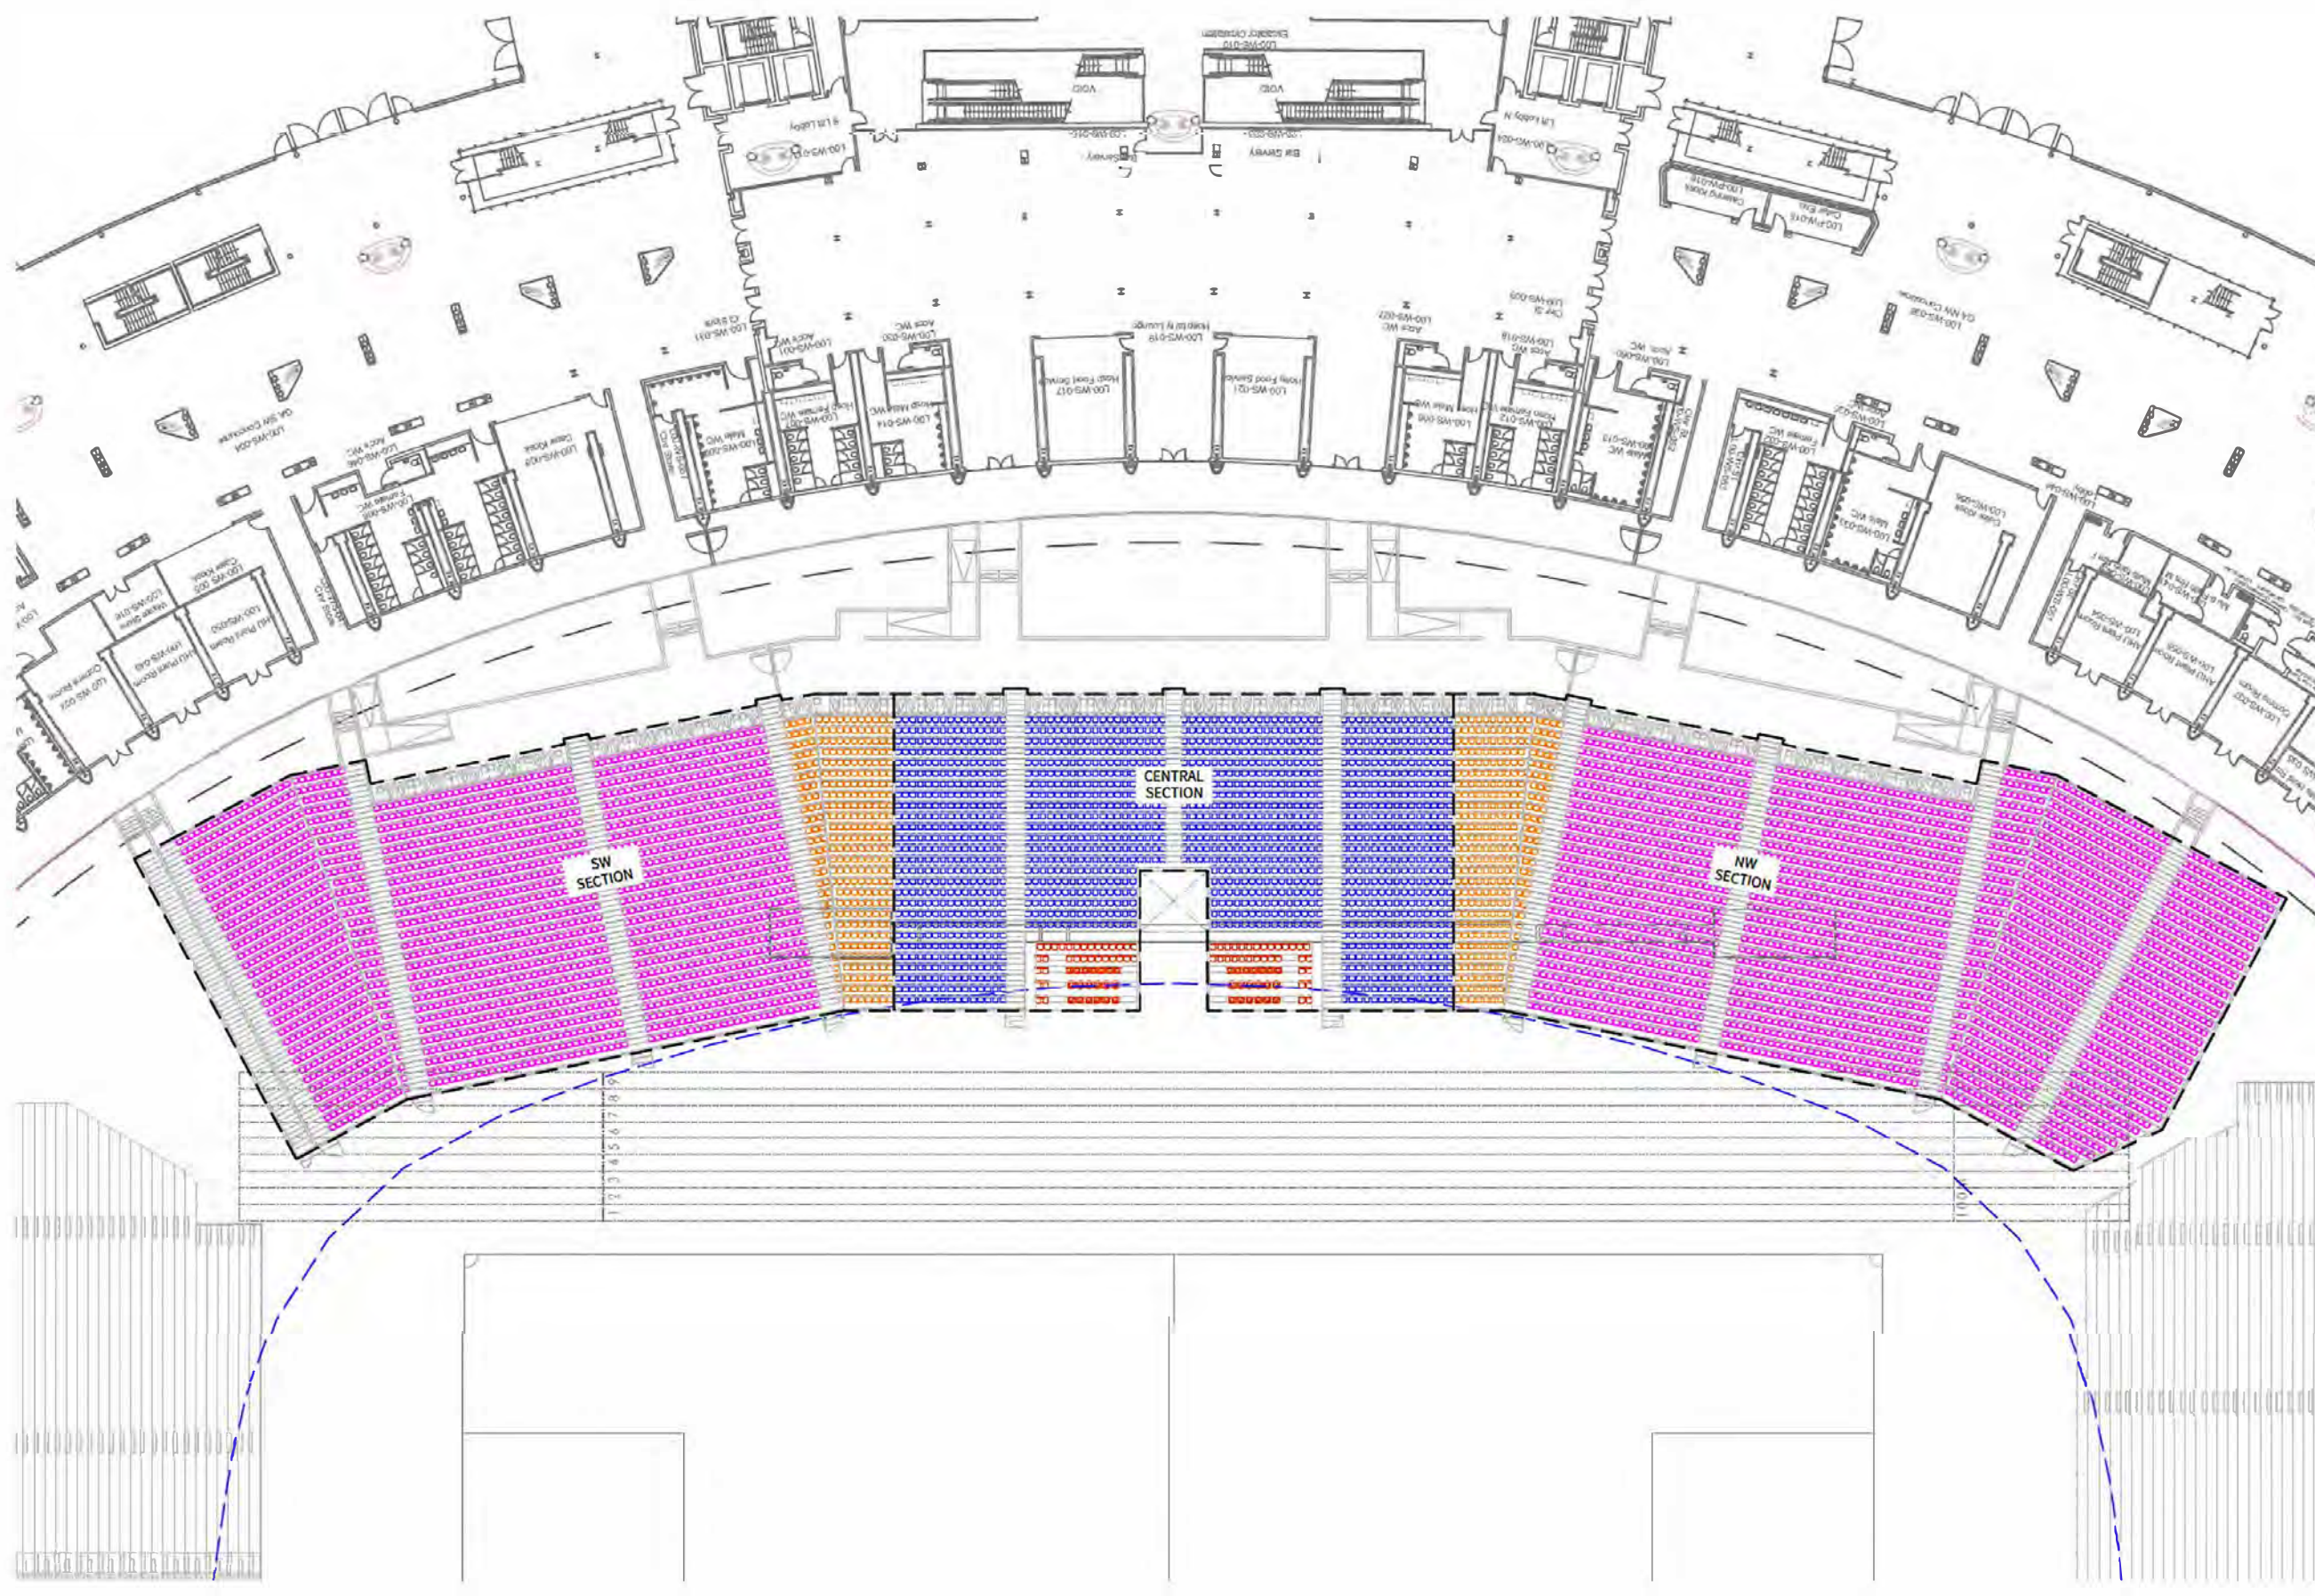

P04	RESTRICTED VIEW SEATING ADDED	RK	JT	11.05.22
P03	ARCHITECTURE REVISED TO LATEST	TO	JT	14.03.22
P02	SEATING - ROW NUMBERS UPDATED	YA	TO	01.03.22
P01	FIRST ISSUE	YA	TO	06.02.22

For information relating to Use, Cleaning and Maintenance see the Health Safety File. It is assumed that all works will be carried out by a competent person.

CLIENT
PREPARED BY: ES GLOBAL ON BEHALF OF: E20 STADIUM LLP

PROJECT TITLE
WEST STAND REPLACEMENT
LONDON STADIUM

DRAWING TITLE
FOOTBALL CONFIGURATION - BLOCK DEFINITION
GENERAL ARRANGEMENT

DATE	SCALE	PAPER SIZE	SUITABILITY
02.02.22	1:500	A3	S4

ISSUE STATUS
CONSTRUCTION

APPROVED BY
TO

DRAWING NO
A2333-ESG-00-B1-GA-W-0101-P04_1

REVISION
P04

NOTE:
ARRANGEMENT SHOWN PRODUCED FOR ILLUSTRATION/QUOTATION PURPOSES ONLY.
(THIS ARRANGEMENT HAS NOT BEEN ENGINEERED AND IS THUS SUBJECT TO POSSIBLE CHANGES)



ES Global Ltd.
Unit G East, Coate House, 1-3 Coate Street, London E2 9AG
T. +44 (0)20 7055 7200 F. +44 (0)20 7055 7201
E. info@esglobalsolutions.com
W. esglobalsolutions.com

- This drawing is copyright and the property of ES Global Ltd. It must not be copied or used, in part or whole, without their written consent. Failure to do so may lead to legal proceedings under the copyright, Design and Patent Act 1988.
- The information shown on this drawing is based upon information supplied to ES Global Ltd. by the client.
- It is the responsibility of the client to:
 - check that their requirements have been correctly interpreted;
 - confirm the receipt and the validity of the drawing contents in writing to the issuing office ES Global Ltd.
- Any modification to the details shown on this drawing MUST be referred to ES Global Ltd. for their information and approval.
- All dimensions in MILLIMETRES - unless noted otherwise.
- Do NOT scale from this drawing. Work only to figured dimensions.

- NOTES
- GENERAL ADMISSION SEATING
 - MAIN HOSPITALITY SEATING
 - PREMIUM GA SEATING
 - DUGOUT SEATING
 - DISABLED SEATING
 - RESTRICTED VIEW SEATING



P04	RESTRICTED VIEW SEATING ADDED	RK	JT	11.05.22
P03	ARCHITECTURE REVISED TO LATEST	TO	JT	14.03.22
P02	SEATING - ROW NUMBERS UPDATED	YA	TO	01.03.22
P01	FIRST ISSUE	YA	TO	06.02.22

For information relating to Use, Clearing and Maintenance see the Health & Safety File. It is assumed that all works will be carried out by a competent person.

CLIENT PREPARED BY ES GLOBAL ON BEHALF OF: E20 STADIUM LLP			
PROJECT TITLE WEST STAND REPLACEMENT LONDON STADIUM			
DRAWING TITLE FOOTBALL CONFIGURATION - SOUTH WEST SECTION BLOCK 110-113			
DATE 02.02.22	SCALE 1:200	PAPER SIZE A3	SUITABILITY S4
ISSUE STATUS CONSTRUCTION		APPROVED BY TO	
DRAWING NO. A2333-ESG-00-B1-GA-W-0101-P04_2		REVISION P04	

NOTE:
ARRANGEMENT SHOWN PRODUCED FOR ILLUSTRATION/QUOTATION PURPOSES ONLY.
(THIS ARRANGEMENT HAS NOT BEEN ENGINEERED AND IS THUS SUBJECT TO POSSIBLE CHANGES)



ES Global Ltd.
Unit G East, Coate House, 1-3 Coate Street, London E2 9AG
T. +44 (0)20 7055 7200 F. +44 (0)20 7055 7201
E. info@esglobalsolutions.com
W. esglobalsolutions.com

1. This drawing is copyright and the property of ES Global Ltd. It must not be copied or used, in part or whole, without their written consent. Failure to do so may lead to legal proceedings under the copyright, Design and Patent Act 1988.
2. The information shown on this drawing is based upon information supplied to ES Global Ltd. by the client.
It is the responsibility of the client to:
(i) check that their requirements have been correctly interpreted
(ii) confirm the accuracy and the validity of the drawing contents in writing to the issuing office ES Global Ltd.
3. Any modification to the details shown on this drawing MUST be referred to ES Global Ltd. for their information and approval.
4. All dimensions in MILLIMETRES - unless noted otherwise.
5. Do NOT scale from this drawing. Work only to figured dimensions.

- NOTES
- GENERAL ADMISSION SEATING
 - MAIN HOSPITALITY SEATING
 - PREMIUM GA SEATING
 - DUGOUT SEATING
 - DISABLED SEATING
 - RESTRICTED VIEW SEATING



P04	RESTRICTED VIEW SEATING ADDED	RK	JT	11.05.22
P03	ARCHITECTURE REVISED TO LATEST	TO	JT	14.03.22
P02	SEATING - ROW NUMBERS UPDATED	YA	TO	01.03.22
P01	FIRST ISSUE	YA	TO	06.02.22

For information relating to Use, Cleaning and Maintenance see the Health Safety File. It is assumed that all works will be carried out by a competent person.

CLIENT	PREPARED BY	ES GLOBAL ON BEHALF OF	E20 STADIUM LLP
PROJECT TITLE	WEST STAND REPLACEMENT LONDON STADIUM		
DRAWING TITLE	FOOTBALL CONFIGURATION - CENTRAL SECTION BL@CK 107-109		
DATE	SCALE	PAPER SIZE	SUITABILITY
02.02.22	1:200	A3	S4
ISSUE STATUS	CONSTRUCTION		APPROVED BY
			TO
DRAWING NO	A2333-ESG-00-B1-GA-W-0101-P04_3		REVISION
			P04

NOTE:
ARRANGEMENT SHOWN PRODUCED FOR ILLUSTRATION/QUOTATION PURPOSES ONLY.
(THIS ARRANGEMENT HAS NOT BEEN ENGINEERED AND IS THUS SUBJECT TO POSSIBLE CHANGES)



ES Global Ltd.
Unit G East, Coate House, 1-3 Coate Street, London E2 9AG
T: +44 (0)20 7055 7200 F: +44 (0)20 7055 7201
E: info@esglobalsolutions.com
W: esglobalsolutions.com

1. This drawing is copyright and the property of ES Global Ltd. It must not be copied or used, in part or whole, without their written consent. Failure to do so may lead to legal proceedings under the copyright, Design and Patent Act 1988.
2. The information shown on this drawing is based upon information supplied to ES Global Ltd. by the client.
3. It is the responsibility of the client to:
(i) check that their requirements have been correctly interpreted
(ii) confirm the accuracy and the validity of the drawing contents in writing to the issuing office ES Global Ltd.
4. Any modification to the details shown on this drawing MUST be referred to ES Global Ltd. for their information and approval.
5. All dimensions in MILLIMETRES - unless stated otherwise.
6. Do NOT scale from this drawing. Work only to stated dimensions.


- NOTES
- GENERAL ADMISSION SEATING
 - MAIN HOSPITALITY SEATING
 - PREMIUM GA SEATING
 - DUGOUT SEATING
 - DISABLED SEATING
 - RESTRICTED VIEW SEATING



P04	RESTRICTED VIEW SEATING ADDED	RK	JT	11.05.22
P03	ARCHITECTURE REVISED TO LATEST	TO	JT	14.03.22
P02	SEATING + ROW NUMBERS UPDATED	YA	TO	01.03.22
P01	FIRST ISSUE	YA	TO	08.02.22

For information relating to Use, Cleaning and Maintenance see the Health and Safety File. It is assumed that all works will be carried out by a competent contractor working, where appropriate, to an approved method statement.


CLIENT			
PREPARED BY ES GLOBAL ON BEHALF OF: E20 STADIUM LLP			
PROJECT TITLE			
WEST STAND REPLACEMENT LONDON STADIUM			
DRAWING TITLE			
FOOTBALL CONFIGURATION - NORTHWEST SECTION BLOCK 103-106			
DATE	SCALE	PAPER SIZE	SUITABILITY
02.02.22	1:200	A3	S4
ISSUE STATUS			APPROVED BY
CONSTRUCTION			TO
DRAWING NO			REVISION
A2333-ESG-00-B1-GA-W-0101-P04_4			P04

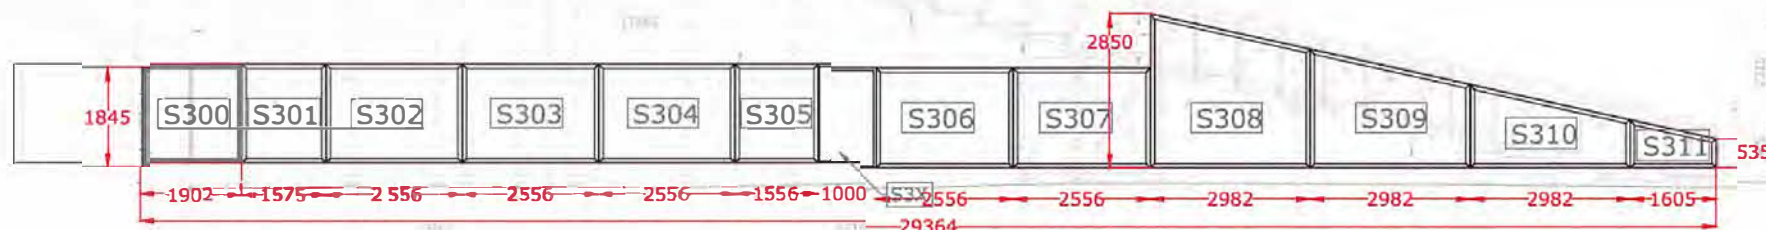


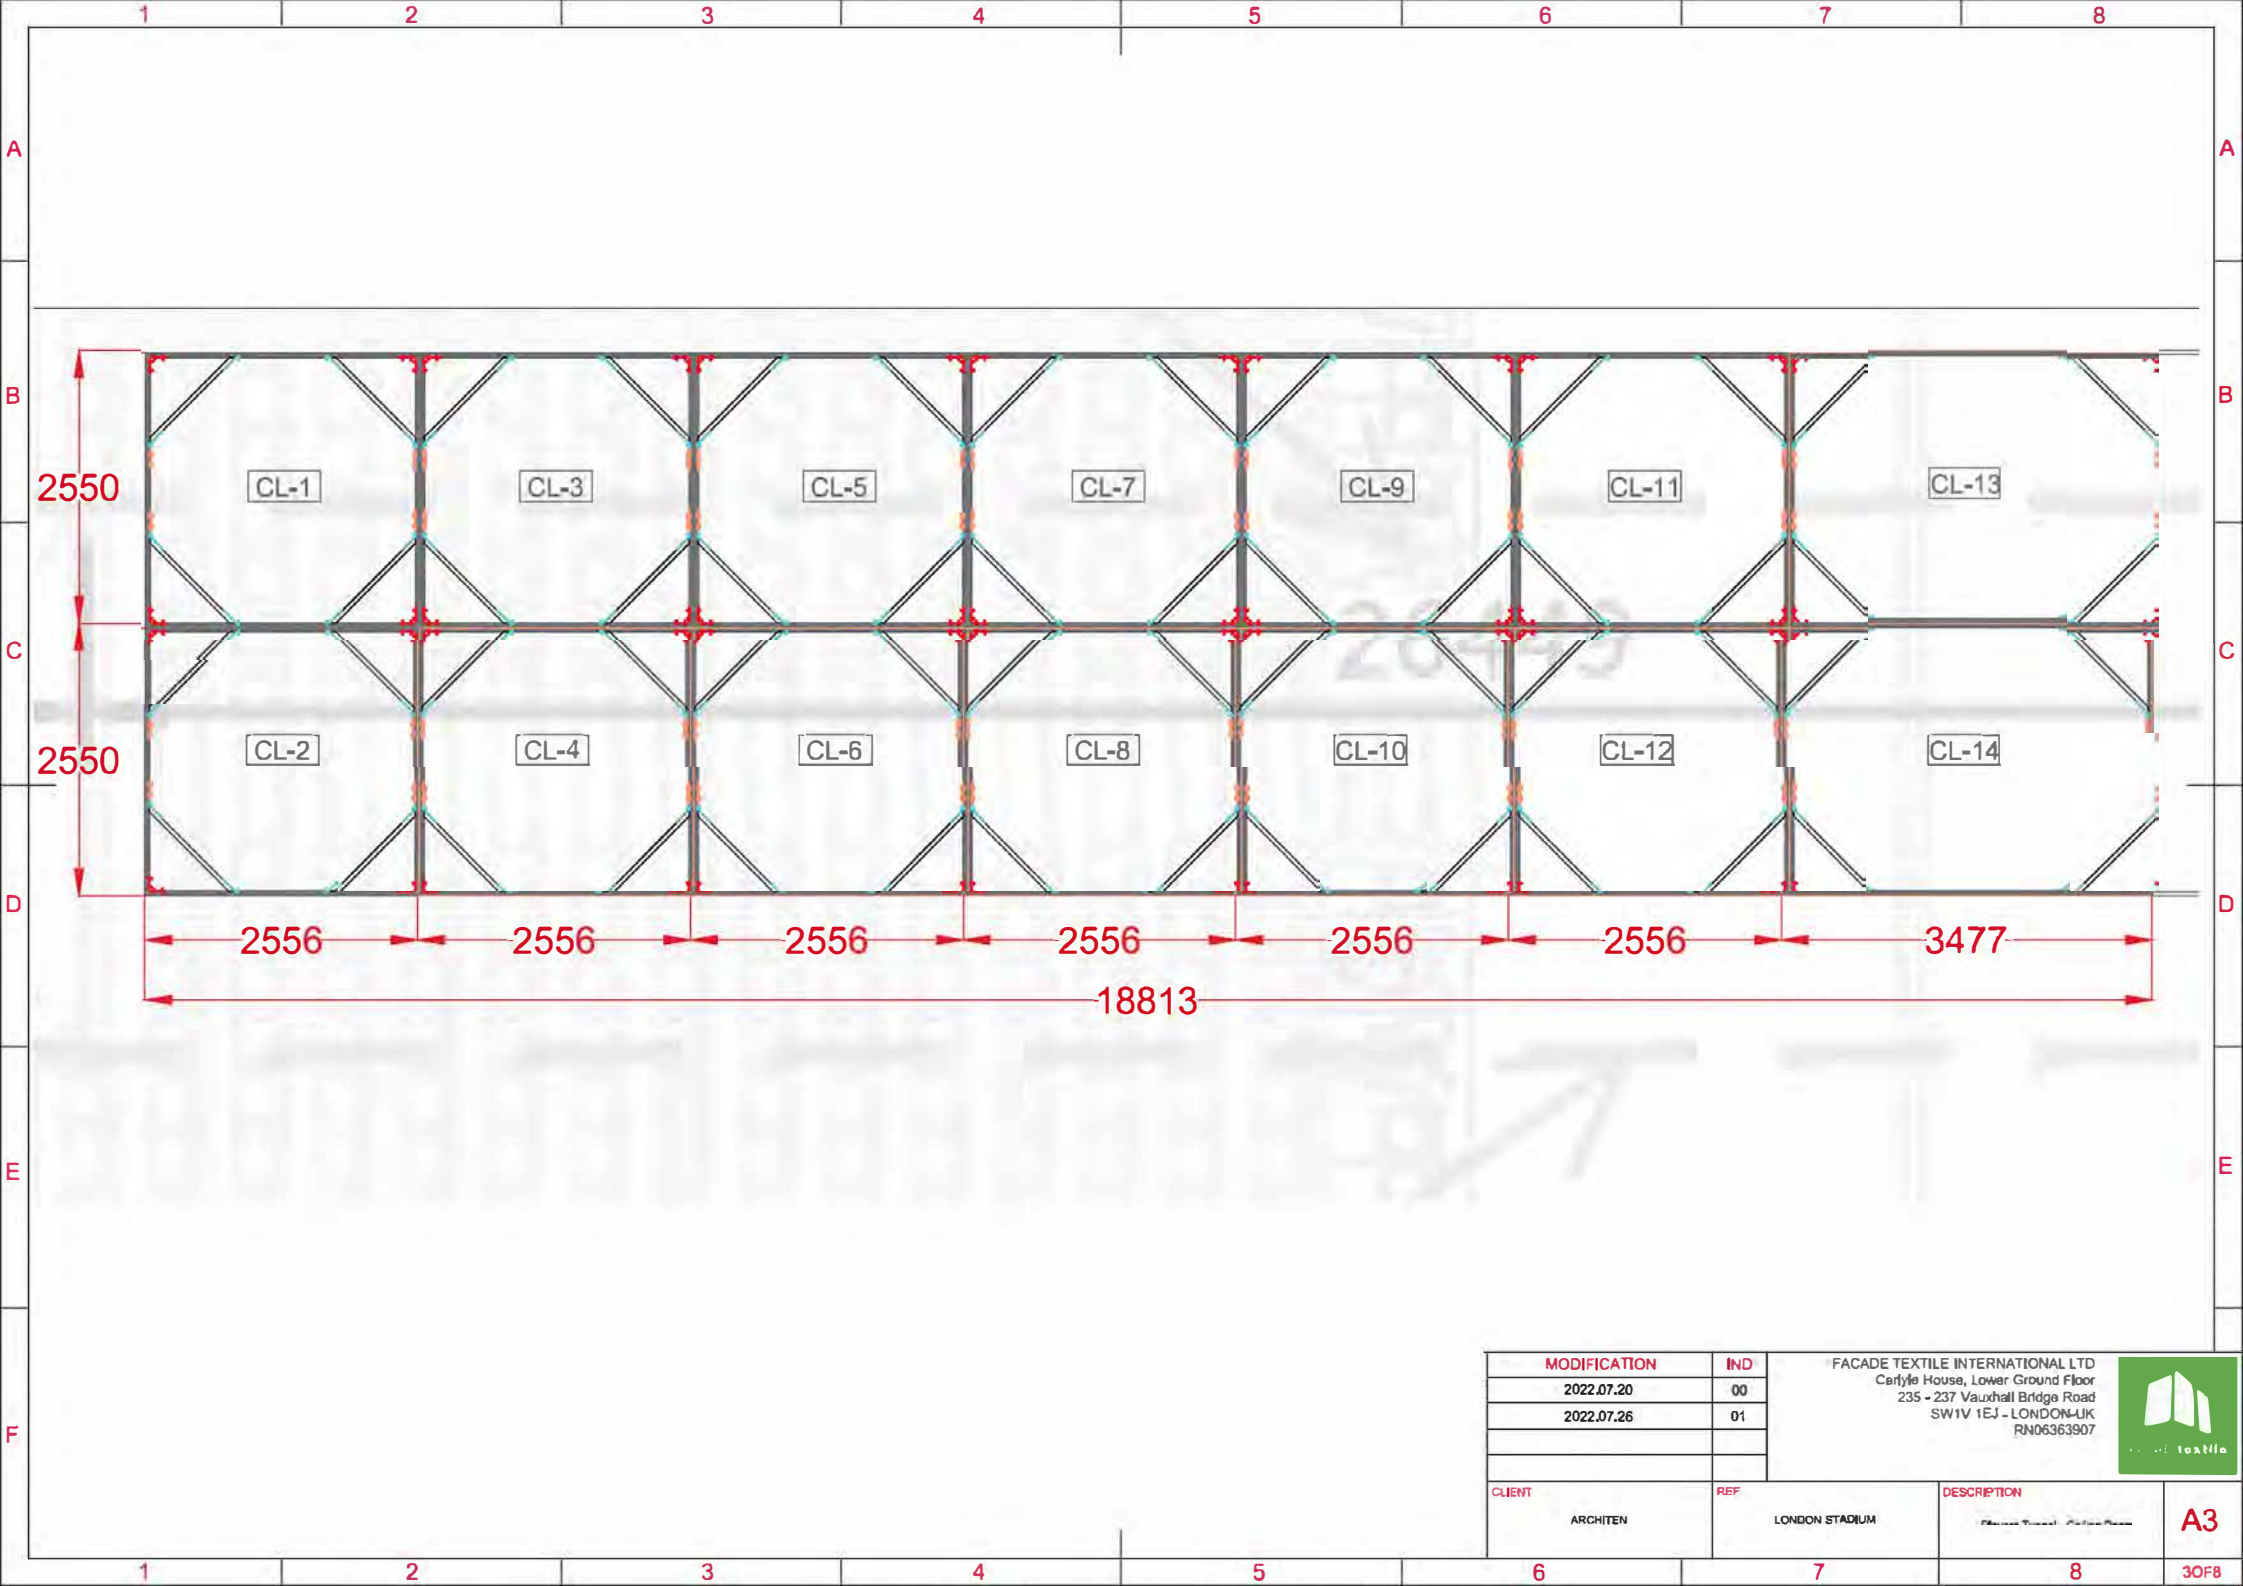
MODIFICATION	IND		
2022.07.20	00	FACADE TEXTILE INTERNATIONAL LTD Carlyle House, Lower Ground Floor 235 - 237 Vauxhall Bridge Road SW1V 1EJ - LONDON-UK RN06363907	
2022.07.26	01		
2022.07.26	02		
CLIENT	REF	DESCRIPTION	
ARCHITEN	LONDON STADIUM	W47 panels	A3




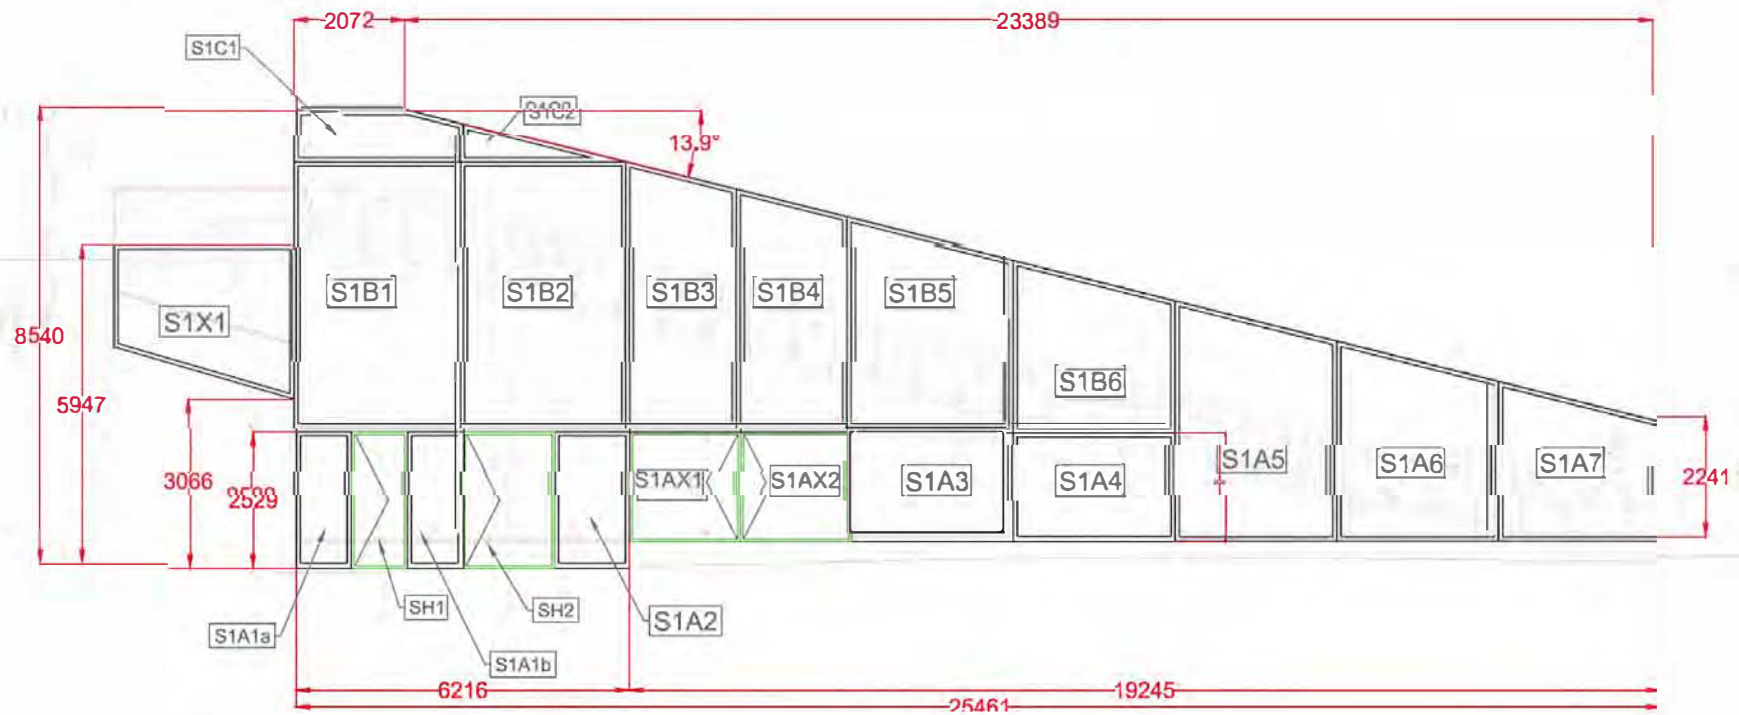
Facade Textile

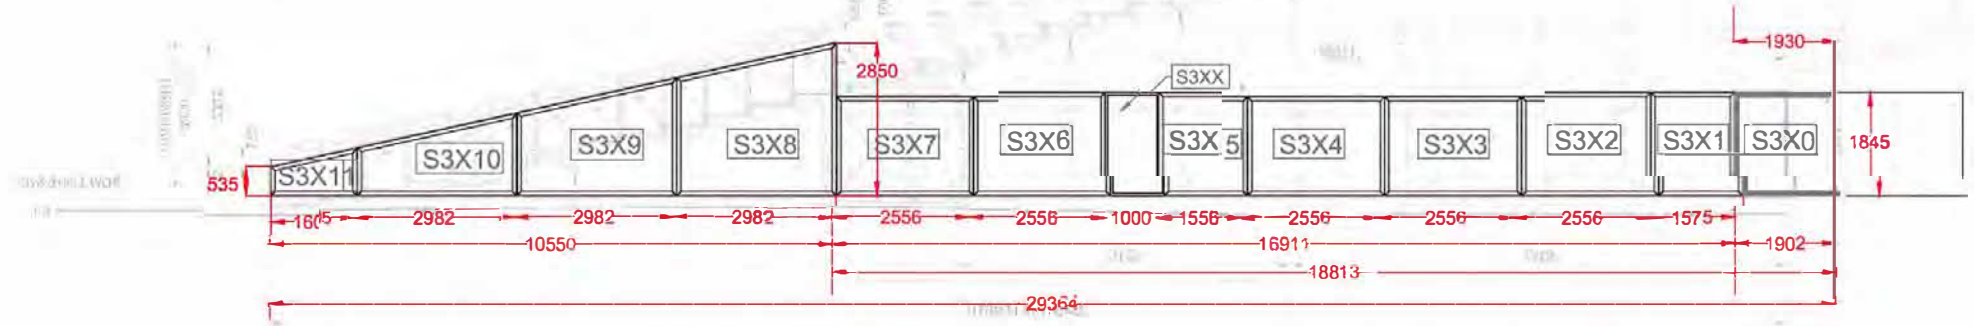


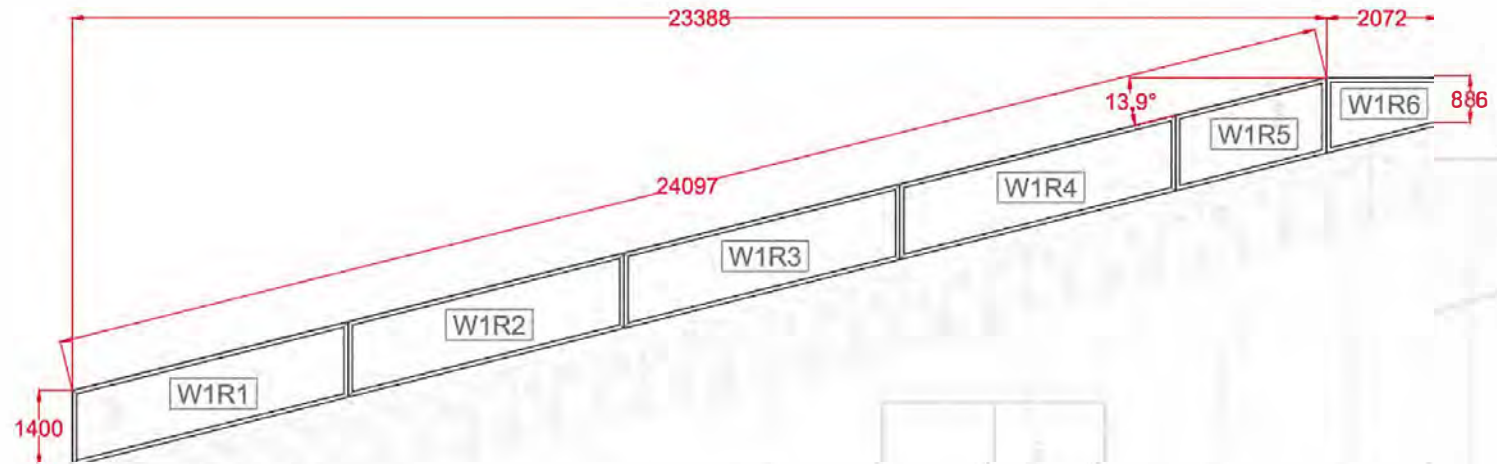
MODIFICATION	IND	FACADE TEXTILE INTERNATIONAL LTD Carlyle House, Lower Ground Floor 235 - 237 Vauxhall Bridge Road SW1V 1EJ - LONDON-UK RN06363907		
2022.07.19	00			
2022.07.26	00			
2022.07.26	01			
CLIENT	REF	DESCRIPTION		
ARCHITEN	LONDON STADIUM	W43 Panels	A3	




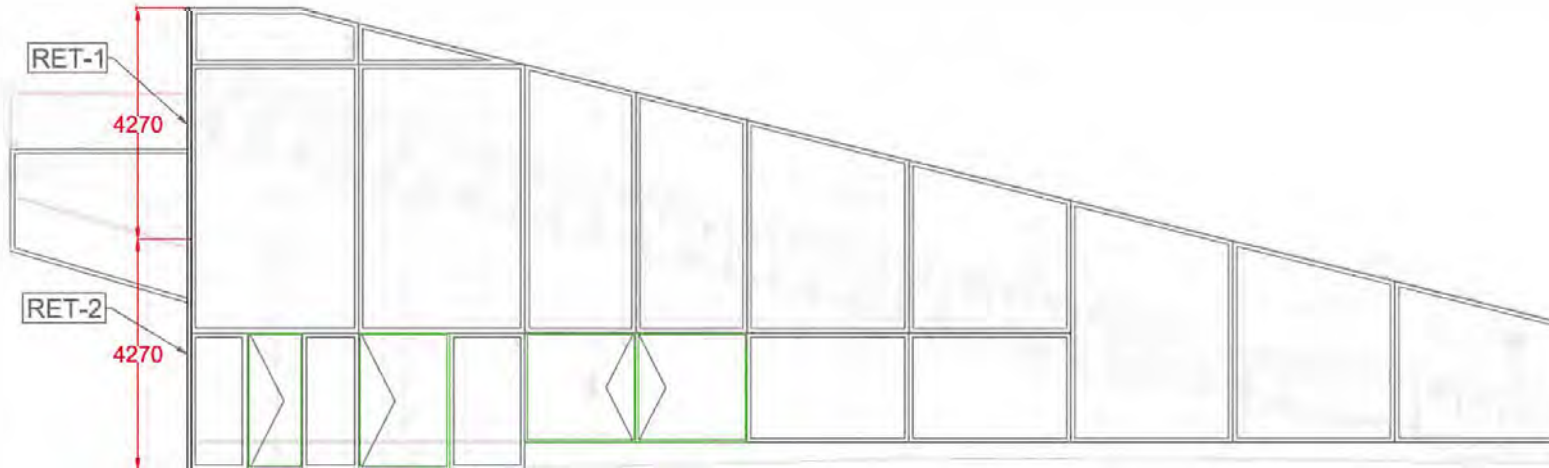
MODIFICATION		IND	FACADE TEXTILE INTERNATIONAL LTD Carlyle House, Lower Ground Floor 235 - 237 Vauxhall Bridge Road SW1V 1EJ - LONDON-UK RN06363907	
2022.07.20		00		
2022.07.26		01		
CLIENT	ARCHITEN	REF	DESCRIPTION	
		LONDON STADIUM		A3




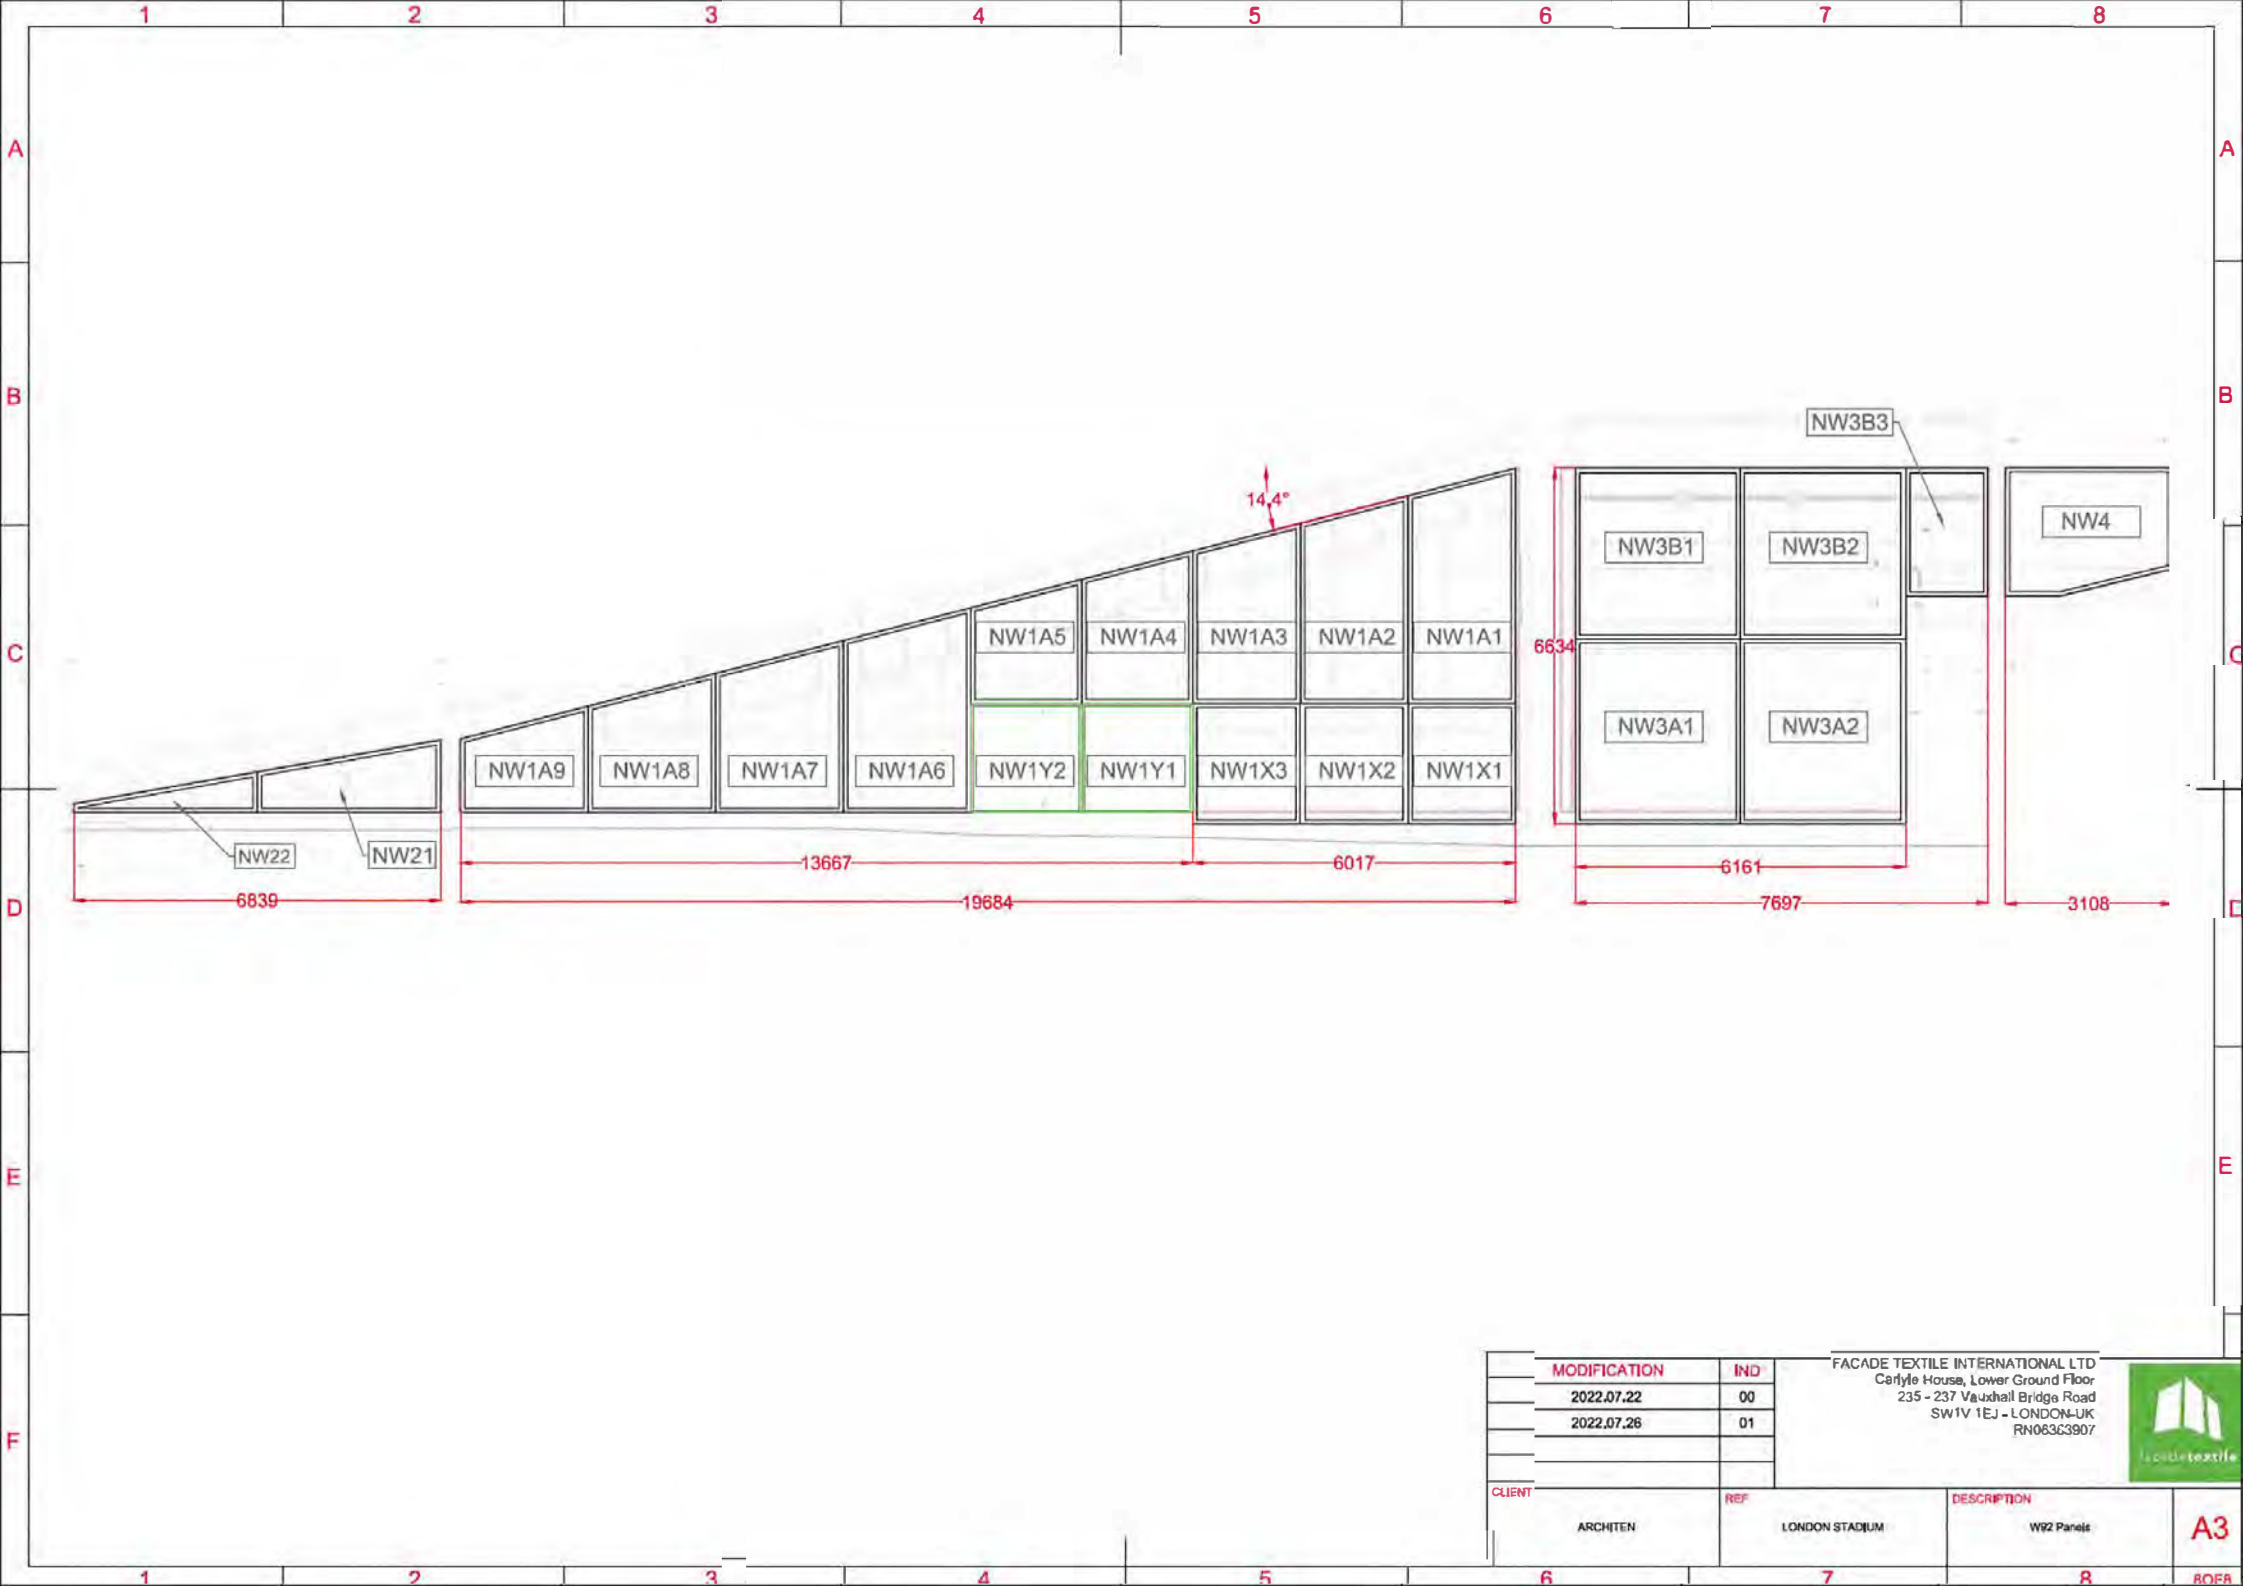
MODIFICATION	IND	FACADE TEXTILE INTERNATIONAL LTD Carlyle House, Lower Ground Floor 235 - 237 Vauxhall Bridge Road SW1V 1EJ - LONDON-UK RN06363907		
2022.07.19	00			
2022.07.26	01			
CLIENT	REF	DESCRIPTION		
ARCHITEN	LONDON STADIUM	W01 PANELS	A3	



MODIFICATION		IND	FACADE TEXTILE INTERNATIONAL LTD Cerlye House, Lower Ground Floor 235 - 237 Vauxhall Bridge Road SW1V 1EJ - LONDON-UK RN06363907	
2022.07.21		00		
2022.07.26		01		
CLIENT	ARCHITEN	REF	DESCRIPTION	
		LONDON STADIUM	W01 Rear Panels	A3



MODIFICATION		IND	FACADE TEXTILE INTERNATIONAL LTD Carlyle House, Lower Ground Floor 235 - 237 Vauxhall Bridge Road SW1V 1EJ - LONDON-UK RN06363907	
2022.07.21		00		
CLIENT	ARCHITEN	REF	DESCRIPTION	A3
		LONDON STADIUM	W01 Return Panels	70FB



MODIFICATION	IND	FACADE TEXTILE INTERNATIONAL LTD Carlyle House, Lower Ground Floor 235 - 237 Vauxhall Bridge Road SW1V 1EJ - LONDON-UK RN063C3907			
2022.07.22	00				
2022.07.26	01				
CLIENT	ARCHITEN	REF	LONDON STADIUM	DESCRIPTION	W92 Panels



From: [redacted] <[redacted]@londonstadium185.com>
Sent: 09 August 2022 11:00
To: [redacted]
Subject: FW: New West Stand SW Panel between home and away supporters



From: s.40 [redacted] <[redacted]@westhamunited.co.uk>
Sent: 22 February 2022 09:31
To: s.40 [redacted] <s.40 [redacted]@westhamunited.co.uk>; Alan Skewis <alan.skewis@londonstadium185.com>; s.40 [redacted] <s.40 [redacted]@westhamunited.co.uk> [redacted] <[redacted]@londonstadium185.com>
Cc: s.40 [redacted] <s.40 [redacted]@londonstadium185.com>
Subject: Re: New West Stand SW Panel between home and away supporters

Hi All

One of the things we discussed was the possibility of having some kind of netting to prevent/reduce the risk of things being thrown. Is this something that can be included as this has been installed at other PL grounds.

Kind Regards

 s.40 [redacted]
Health, Safety and Operations
West Ham United Football Club
Queen Elizabeth Olympic Park
whufc.com
Mobile: s.40 [redacted]

This communication contains information from West Ham United that may be confidential. Except for personal use by the intended recipient, or as expressly authorised by the sender, any person who receives this information is prohibited from disclosing, copying, distributing, and/or using it. If you have received this communication in error, please immediately delete it and all copies, and promptly notify the sender. Nothing in this communication is intended to operate as an electronic signature under applicable law.

From: s.40 [redacted] <[redacted]@westhamunited.co.uk>
Date: Tuesday, 22 February 2022 at 09:28
To: s.40 [redacted] <[redacted]@londonstadium185.com>, s.40 [redacted] <s.40 [redacted]@westhamunited.co.uk>, [redacted] <[redacted]@westhamunited.co.uk>, [redacted] <[redacted]@westhamunited.co.uk>, [redacted] <[redacted]@westhamunited.co.uk>

s.40 [redacted]@londonstadium185.com>
Cc: s.40 [redacted] <[redacted]@londonstadium185.com>
Subject: RE: New West Stand SW Panel between home and away supporters

Hi [redacted],
For me if there are no sight line problems the higher the better. I think what we have at the moment has been a massive improvement.

s.40 [redacted]

From: s.40 [redacted] <s.40 [redacted]@londonstadium185.com>
Sent: 22 February 2022 09:21
To: s.40 [redacted] <s.40 [redacted]@westhamunited.co.uk>; s.40 [redacted] <s.40 [redacted]@westhamunited.co.uk>; s.40 [redacted] <s.40 [redacted]@westhamunited.co.uk>; s.40 [redacted] <s.40 [redacted]@londonstadium185.com>
Cc: s.40 [redacted] <s.40 [redacted]@londonstadium185.com>
Subject: New West Stand SW Panel between home and away supporters

All

Please see some visuals of the new west stand panel in the south west corner.

The images are of a 2m panel. The red line shows a 2.5m height. There do not appear to be sightline issues from going to 2.5m, and it creates a better visual separation of home and away supporters.

[redacted] reviewing from a safety operations perspective, and we are also reviewing if a 2.5m panel is feasible; as well as what it means for other modes;. Could you give the club's thoughts so we can make a holistic decision.

Thanks



Disclaimer

The information contained in this communication from the sender is confidential. It is intended solely for use by the recipient and others authorized to receive it. If you are not the recipient, you are hereby notified that any disclosure, copying, distribution or taking action in relation of the contents of this information is strictly prohibited and may be unlawful.

This email has been scanned for viruses and malware, and may have been automatically archived by Mimecast Ltd, an innovator in Software as a Service (SaaS) for business. Providing a safer and more useful place for your human generated data. Specializing in; Security, archiving and compliance. To find out more [Click Here](#).

From: s.40
To: s.40
Subject: Screen Height Check
Date: 21 February 2022 17:55:24
Attachments: [image886549.png](#)
[image463521.png](#)
[ScreenHeightCheck.pdf](#)

Hi s.40

Please see attached PDF that shows the seated views from the South Stand and Middle Tier across the top off the proposed screen, and the standing views on row 3 and 26 at the southernmost end of the West stand looking towards the away fans.

The red line is a 500mm offset above the proposed 2m high screen to show the effect a 2.5m screen would have on views.

Many thanks,

s.40 RIBA
Senior Architect

s.40 @kssgroup.com | s.40




s.40 s.40


London 1 James Street London W1U 1DR


Kent 7 Blighs Walk Sevenoaks TN13 1DB


[Sports Business Awards 2020 Silver](#)

 


Consider the environment before printing.
To view the KSS email disclaimer, please [click here](#).

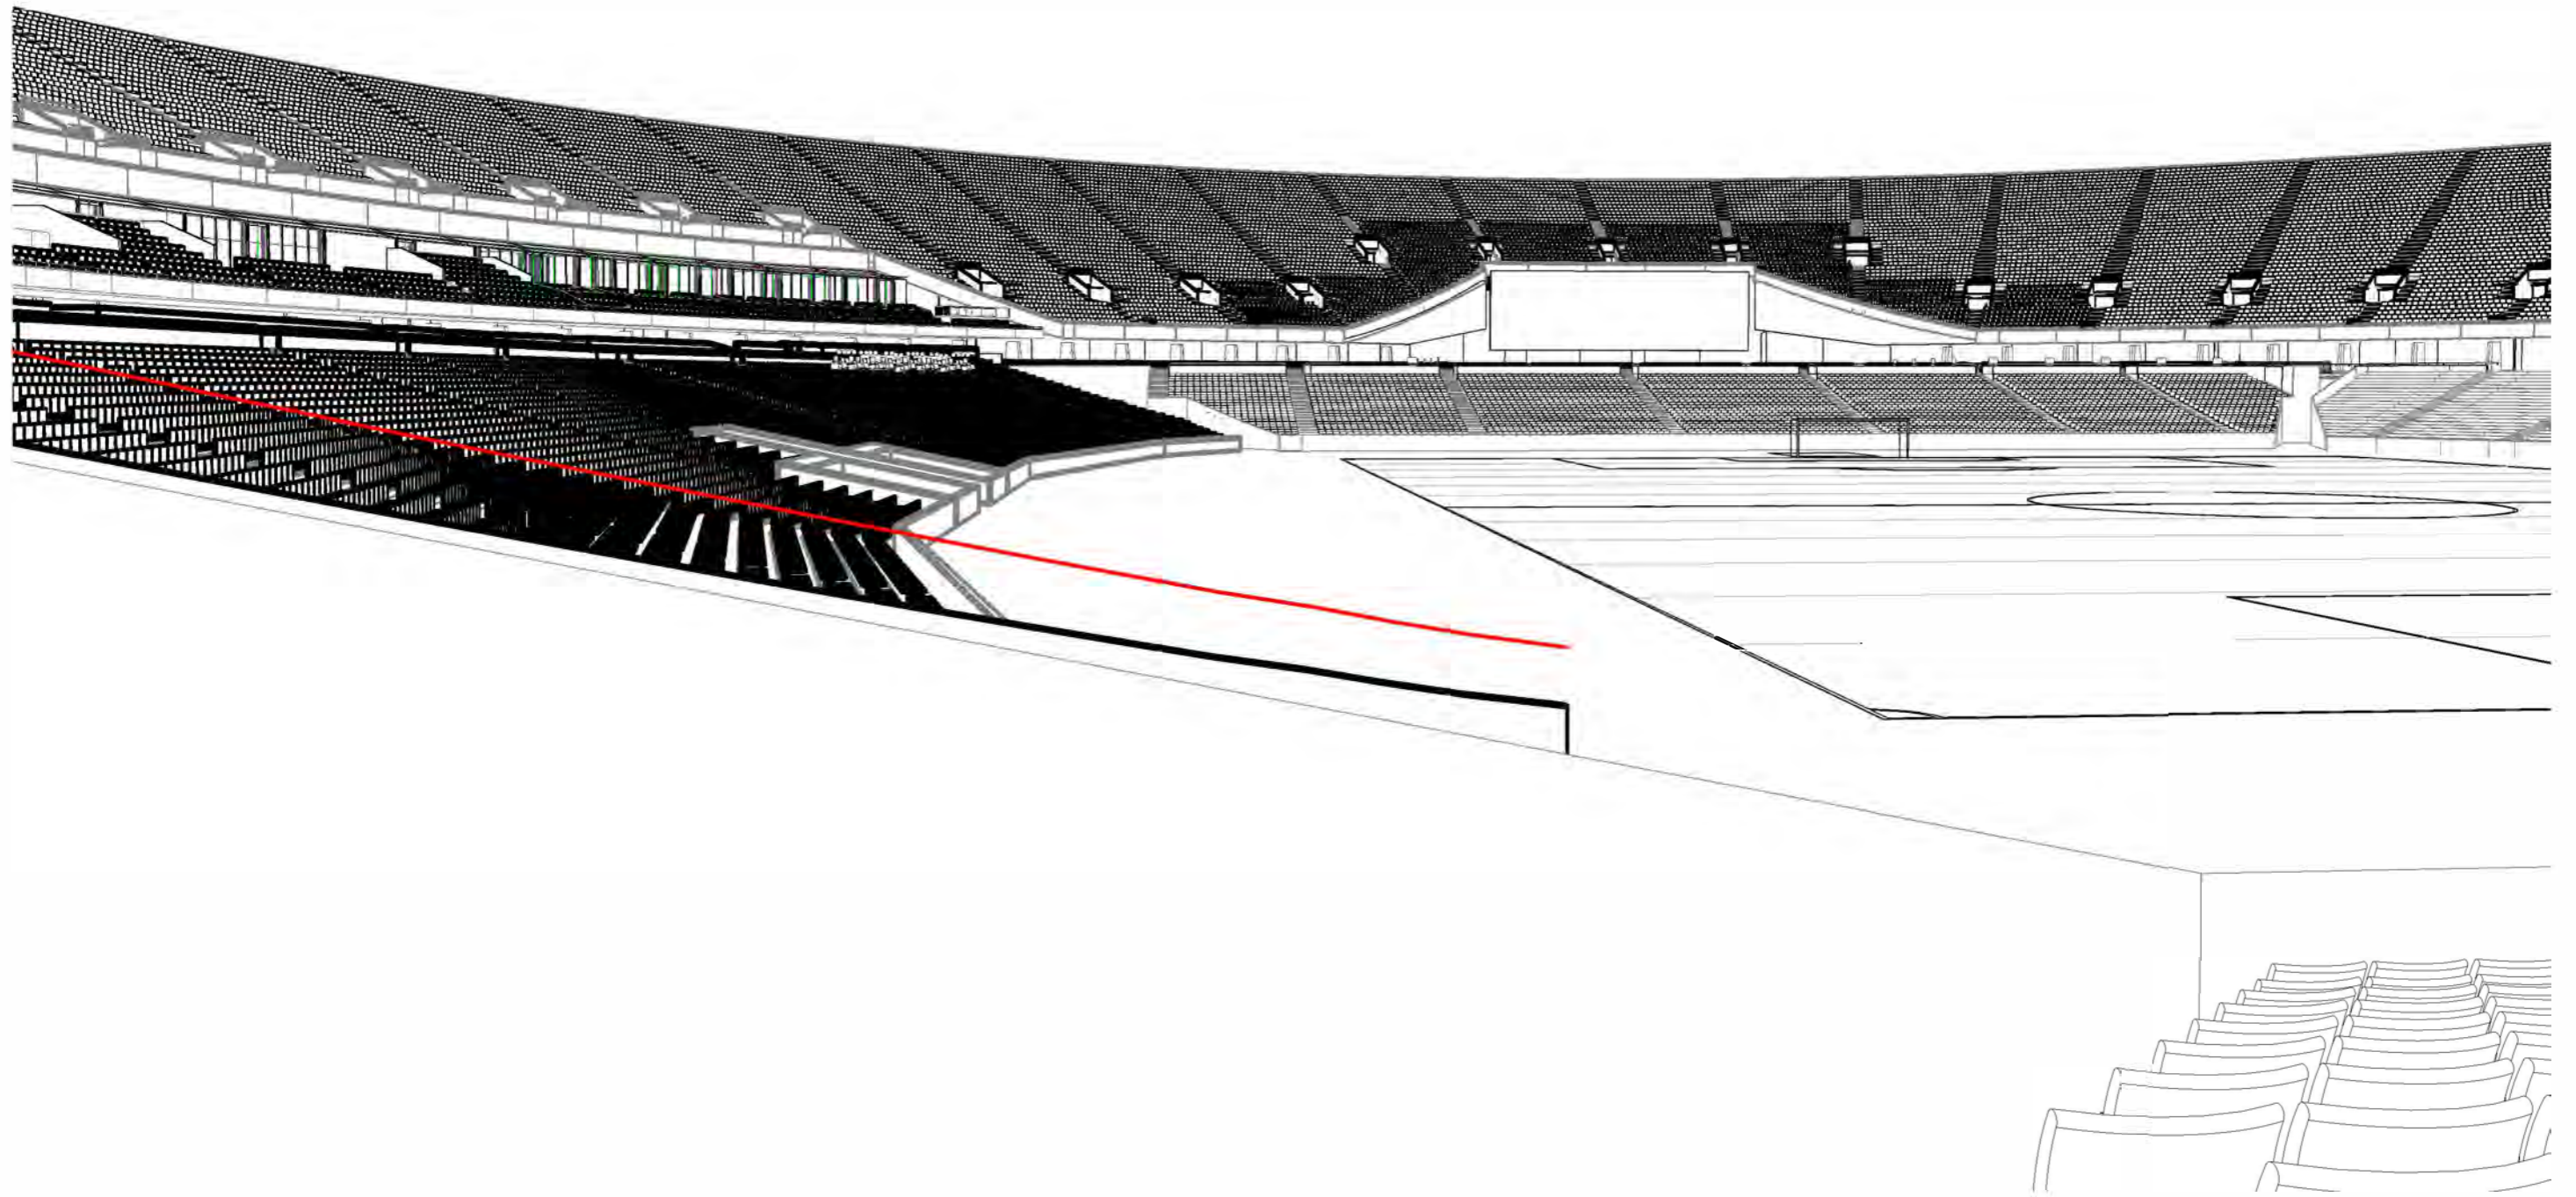

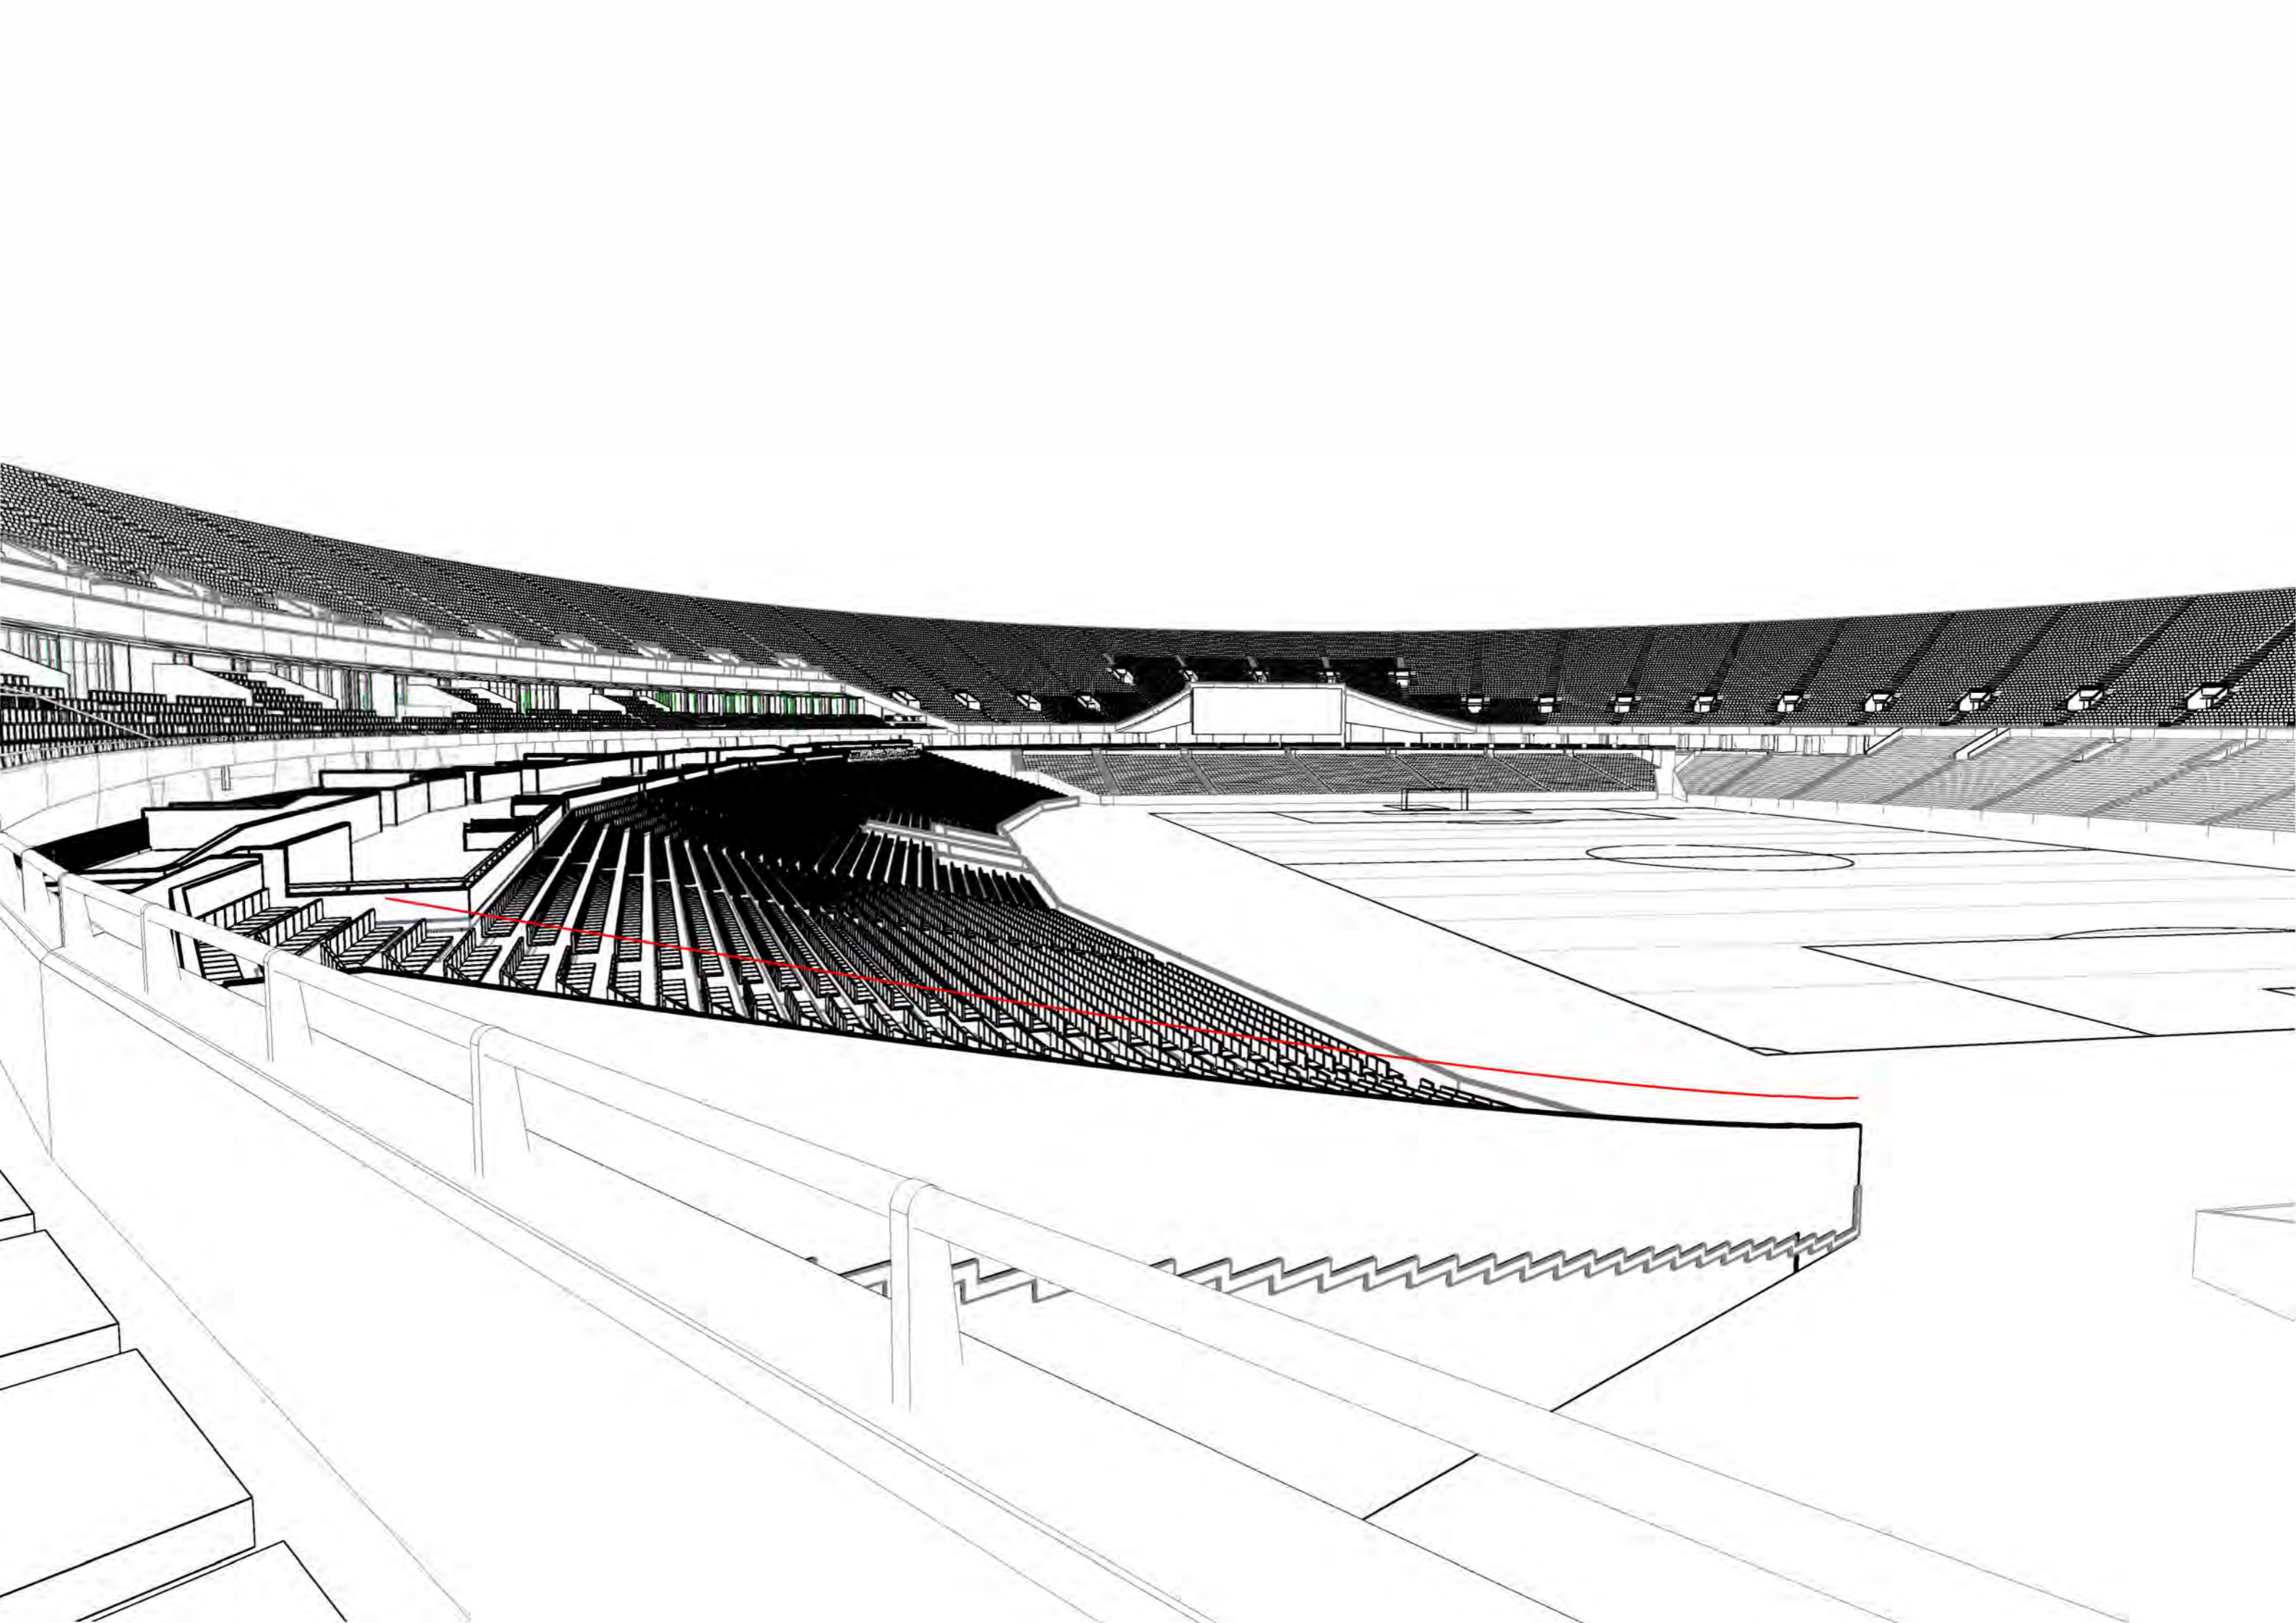

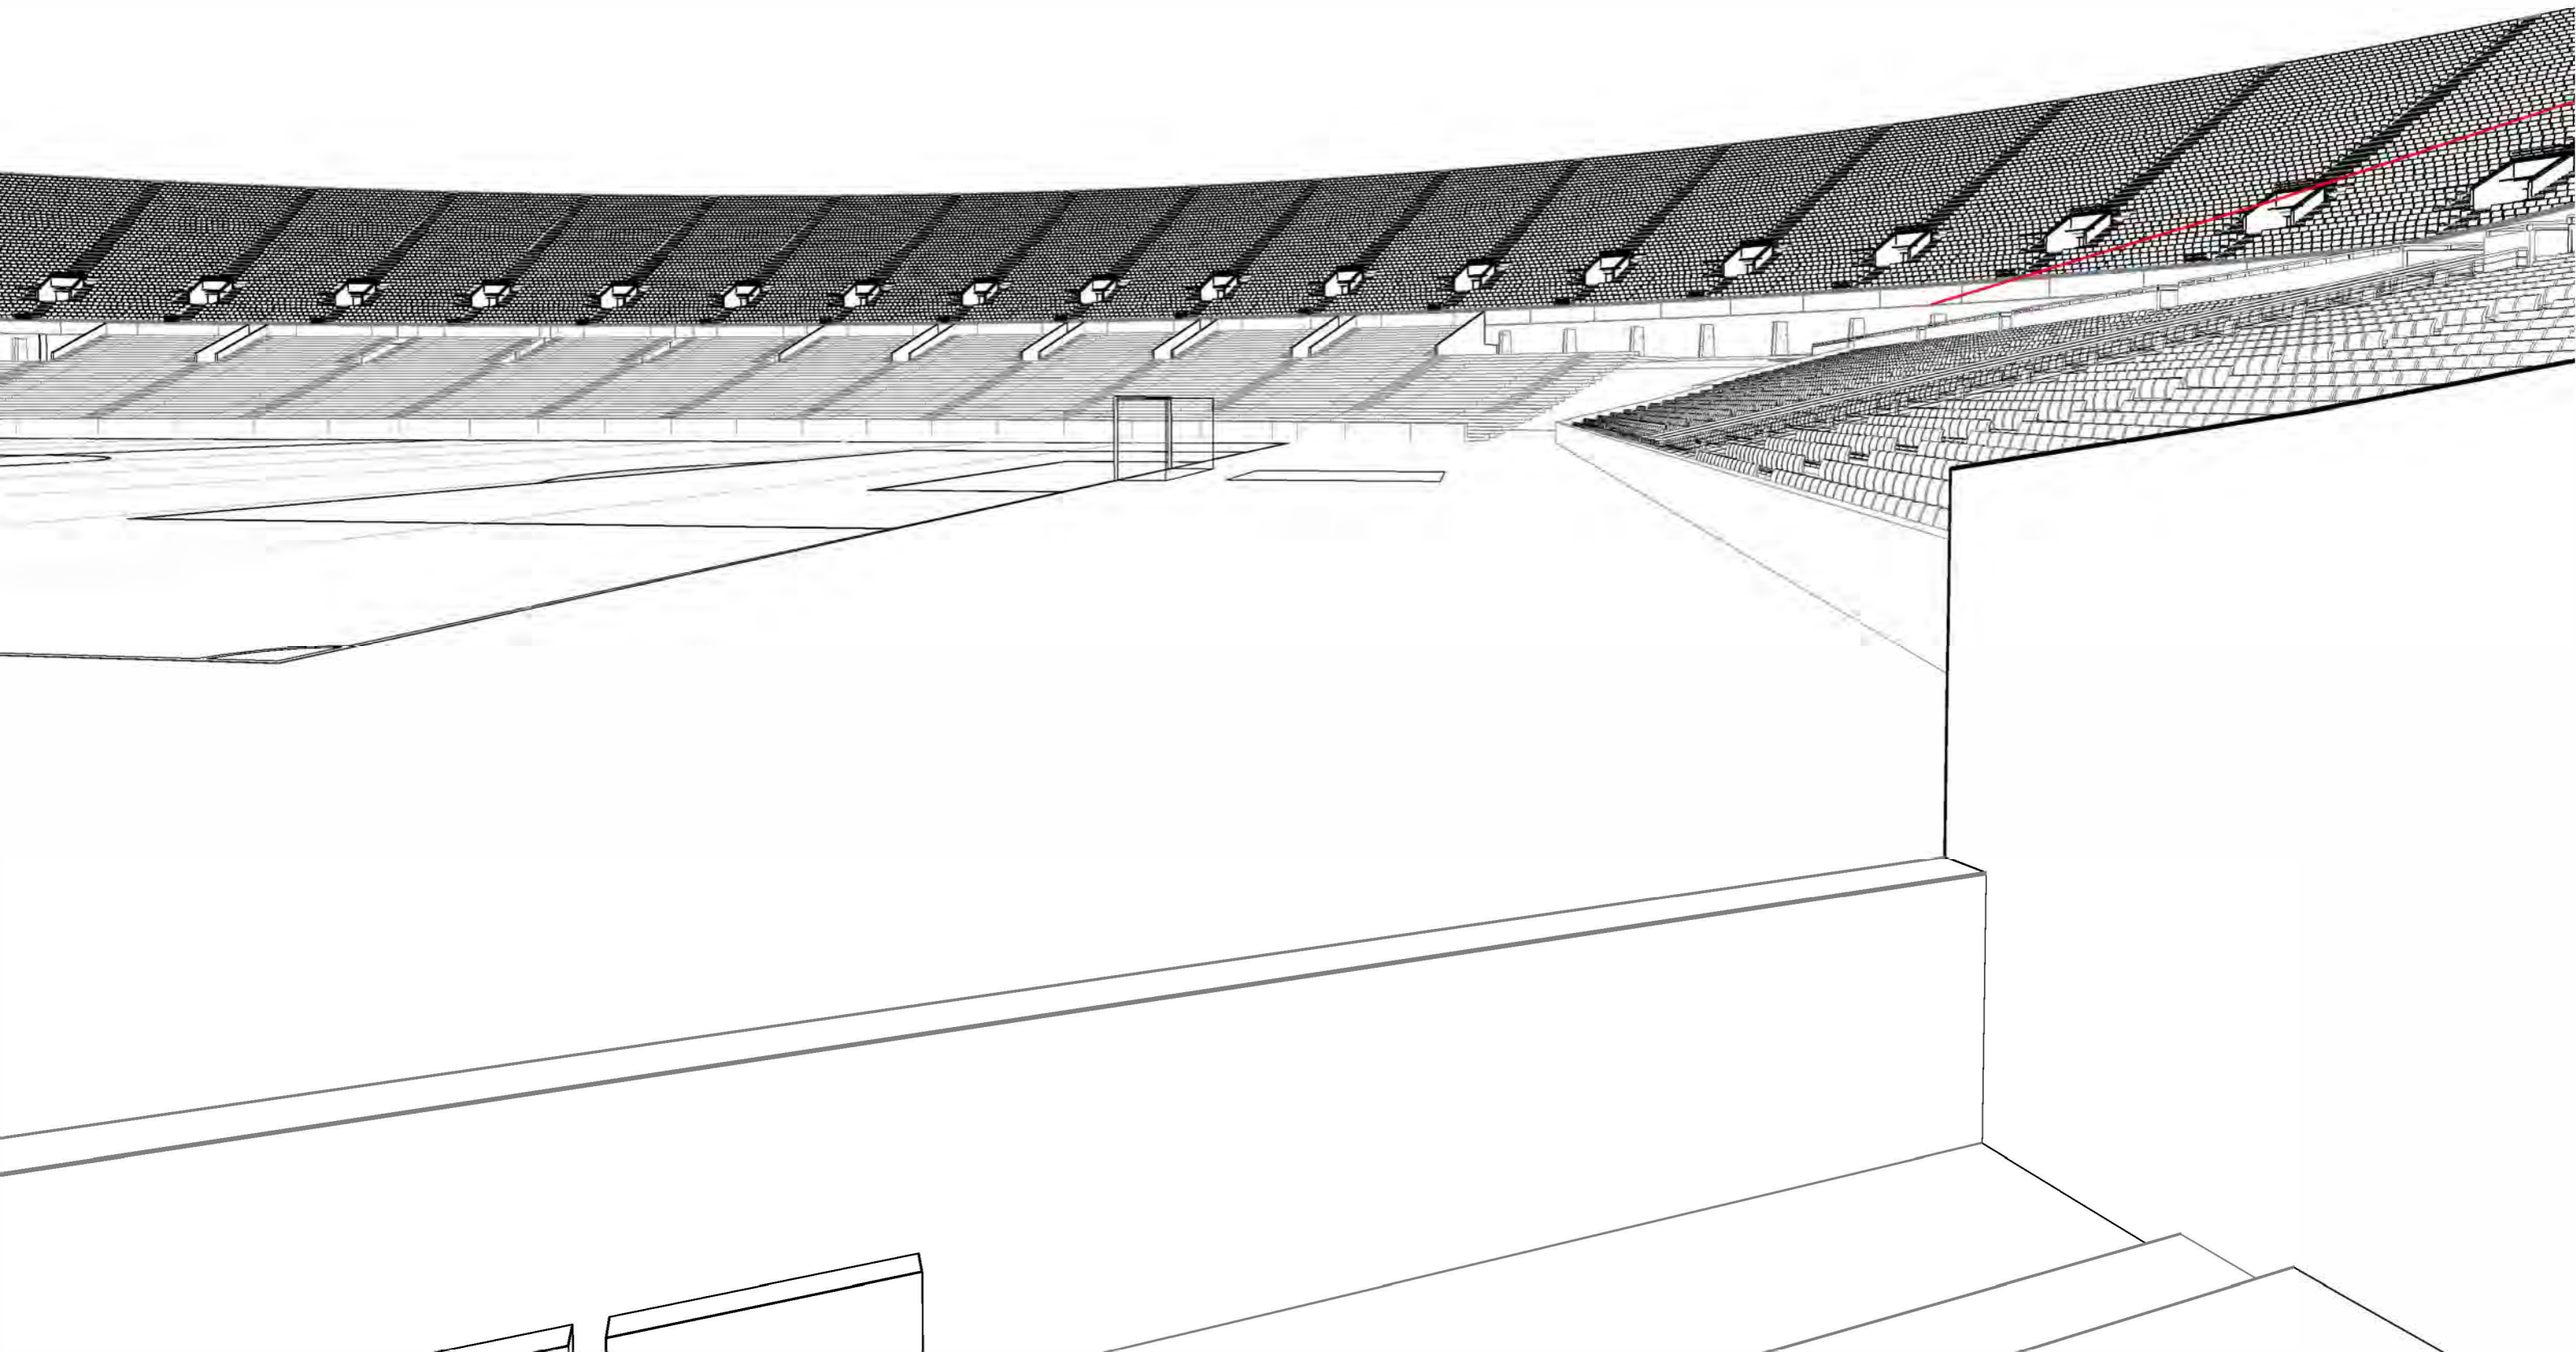

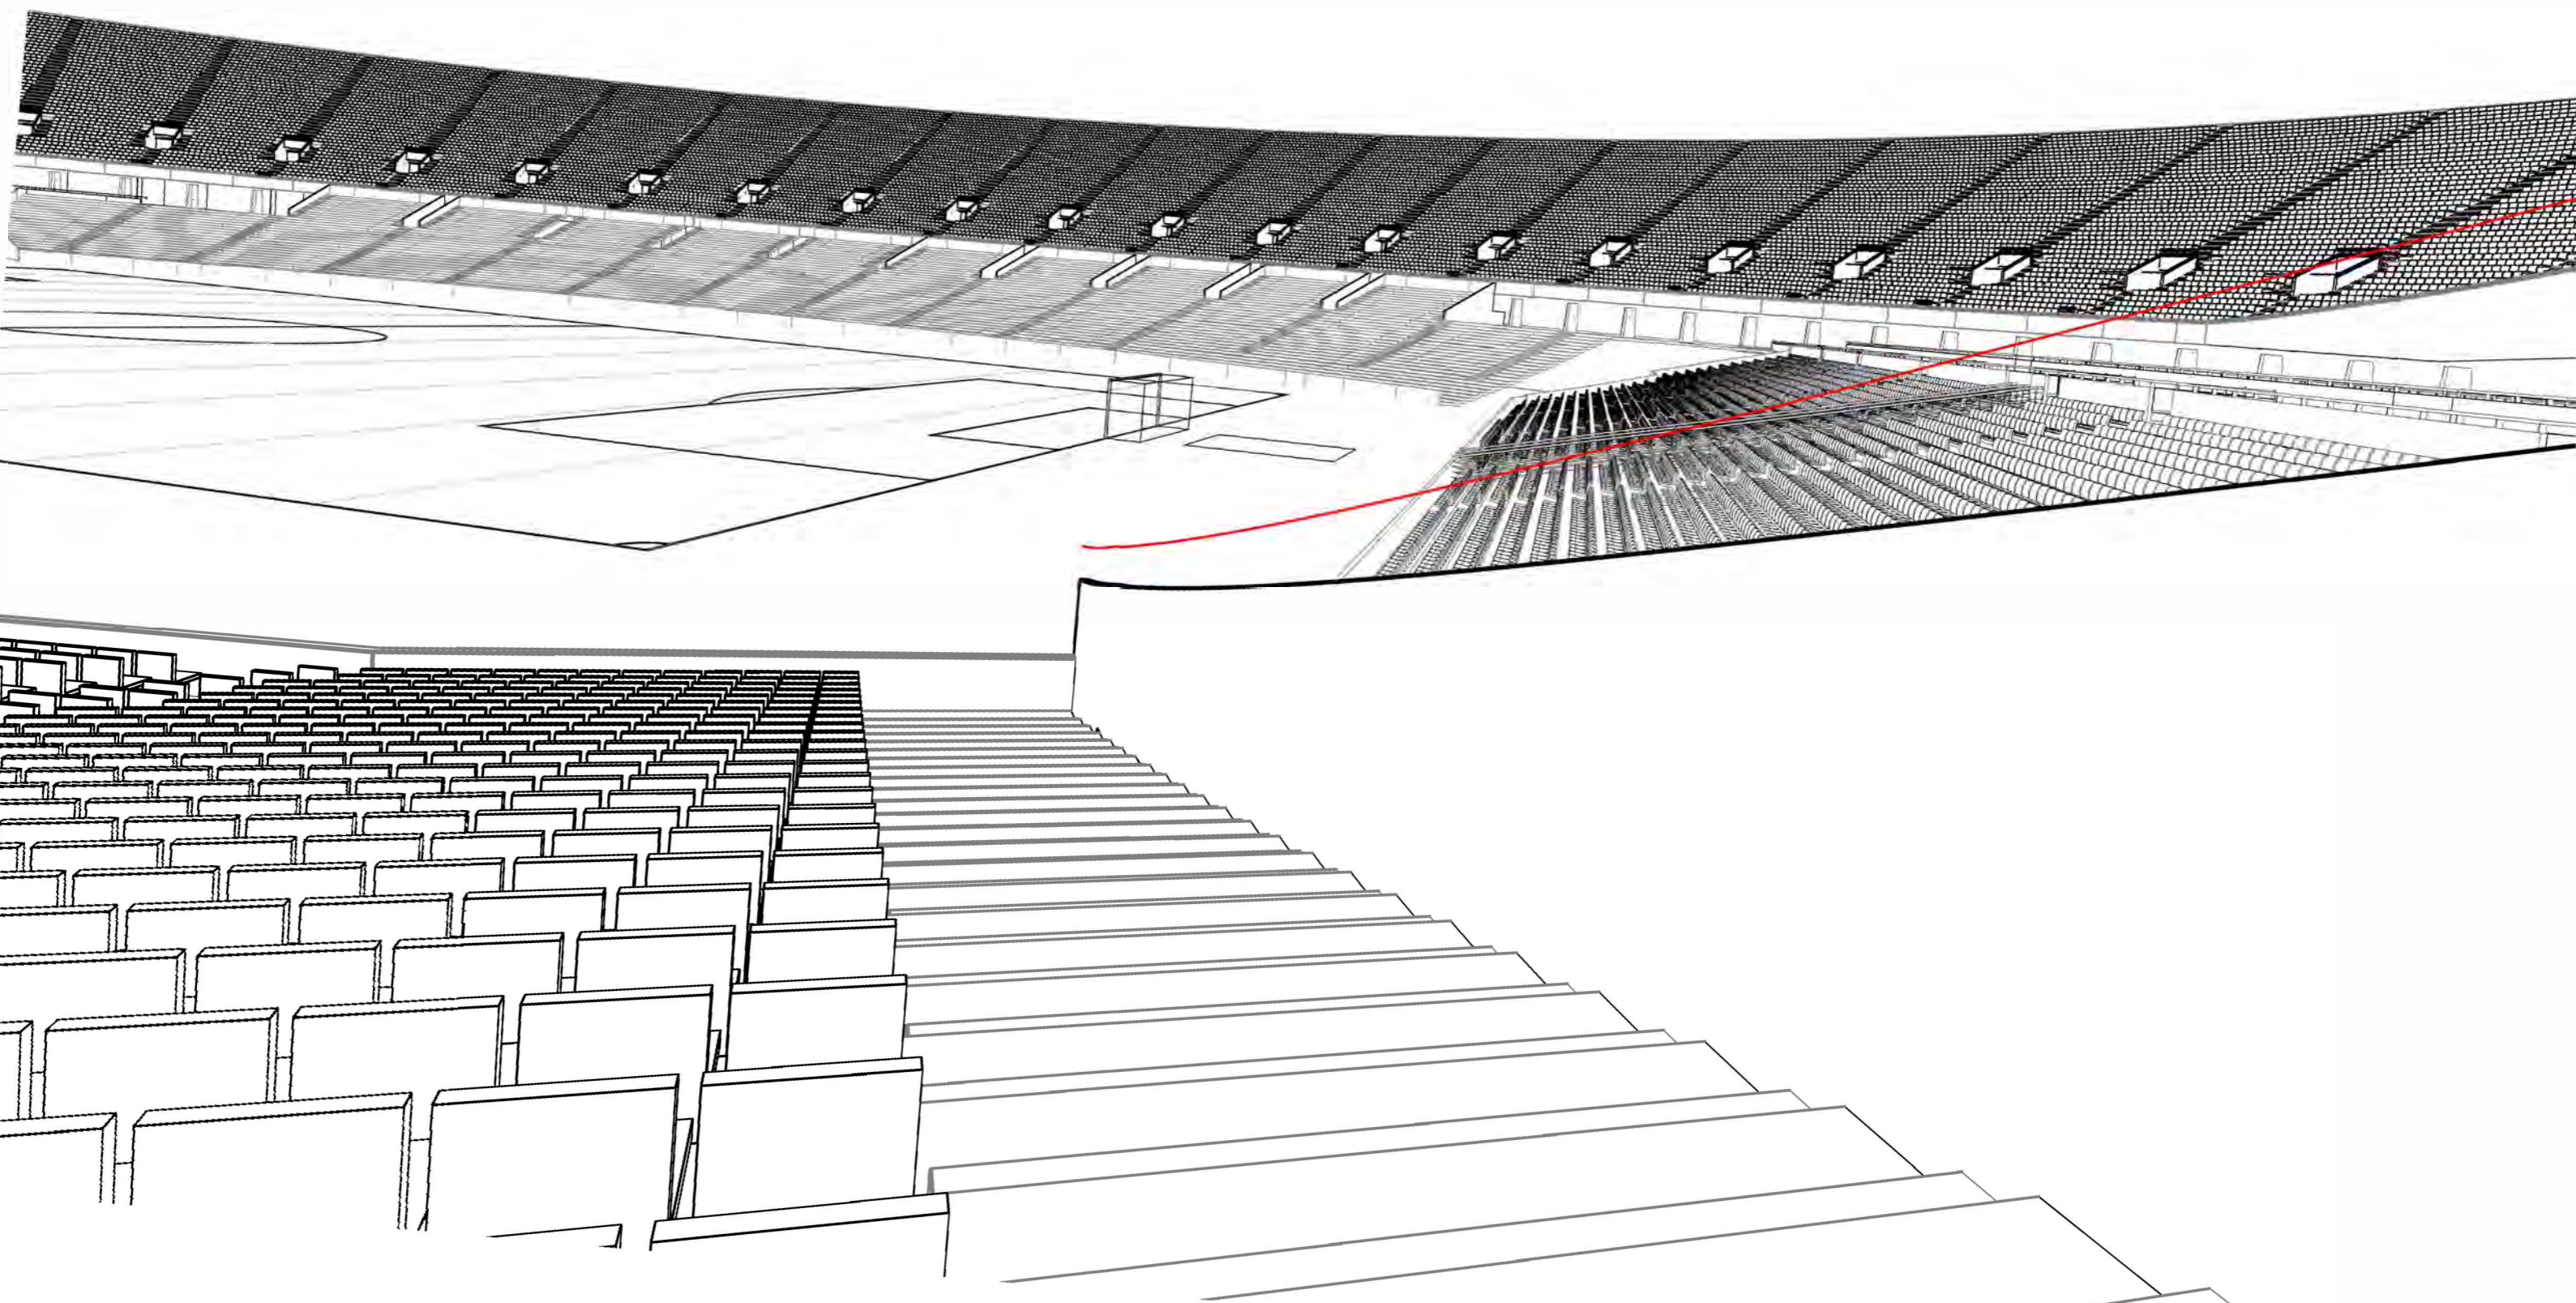


NOTE:
ARRANGEMENT SHOWN PRODUCED FOR ILLUSTRATION/QUOTATION PURPOSES ONLY.
(THIS ARRANGEMENT HAS NOT BEEN ENGINEERED AND IS THUS SUBJECT TO POSSIBLE CHANGES)



ES Global Ltd.
Unit G East, Coate House, 1-3 Coate Street, London E9 6AG
T. +44 (0)20 7055 7200 F. +44 (0)20 7055 7201
E. info@esglobalsolutions.com
W. esglobalsolutions.com

- This drawing is copyright and the property of ES Global Ltd. It must NOT be copied or used, in part or whole, without their written consent. Failure to do so may lead to legal proceedings under the copyright, Design and Patent Act 1988.
- The information shown on this drawing is based upon information supplied to ES Global Ltd. by the client.
- It is the responsibility of the client to:
 - check that their requirements have been correctly interpreted;
 - confirm the receipt and the validity of the drawing contents in writing to the issuing office ES Global Ltd.
- Any modification to the details shown on this drawing MUST be referred to ES Global Ltd. for their information and approval.
- All dimensions in MILLIMETRES - unless noted otherwise.
- Do NOT scale from this drawing. Work only to figured dimensions.

- NOTES
- GENERAL ADMISSION SEATING
 - MAIN HOSPITALITY SEATING
 - PREMIUM GA SEATING
 - DUGOUT SEATING
 - DISABLED SEATING

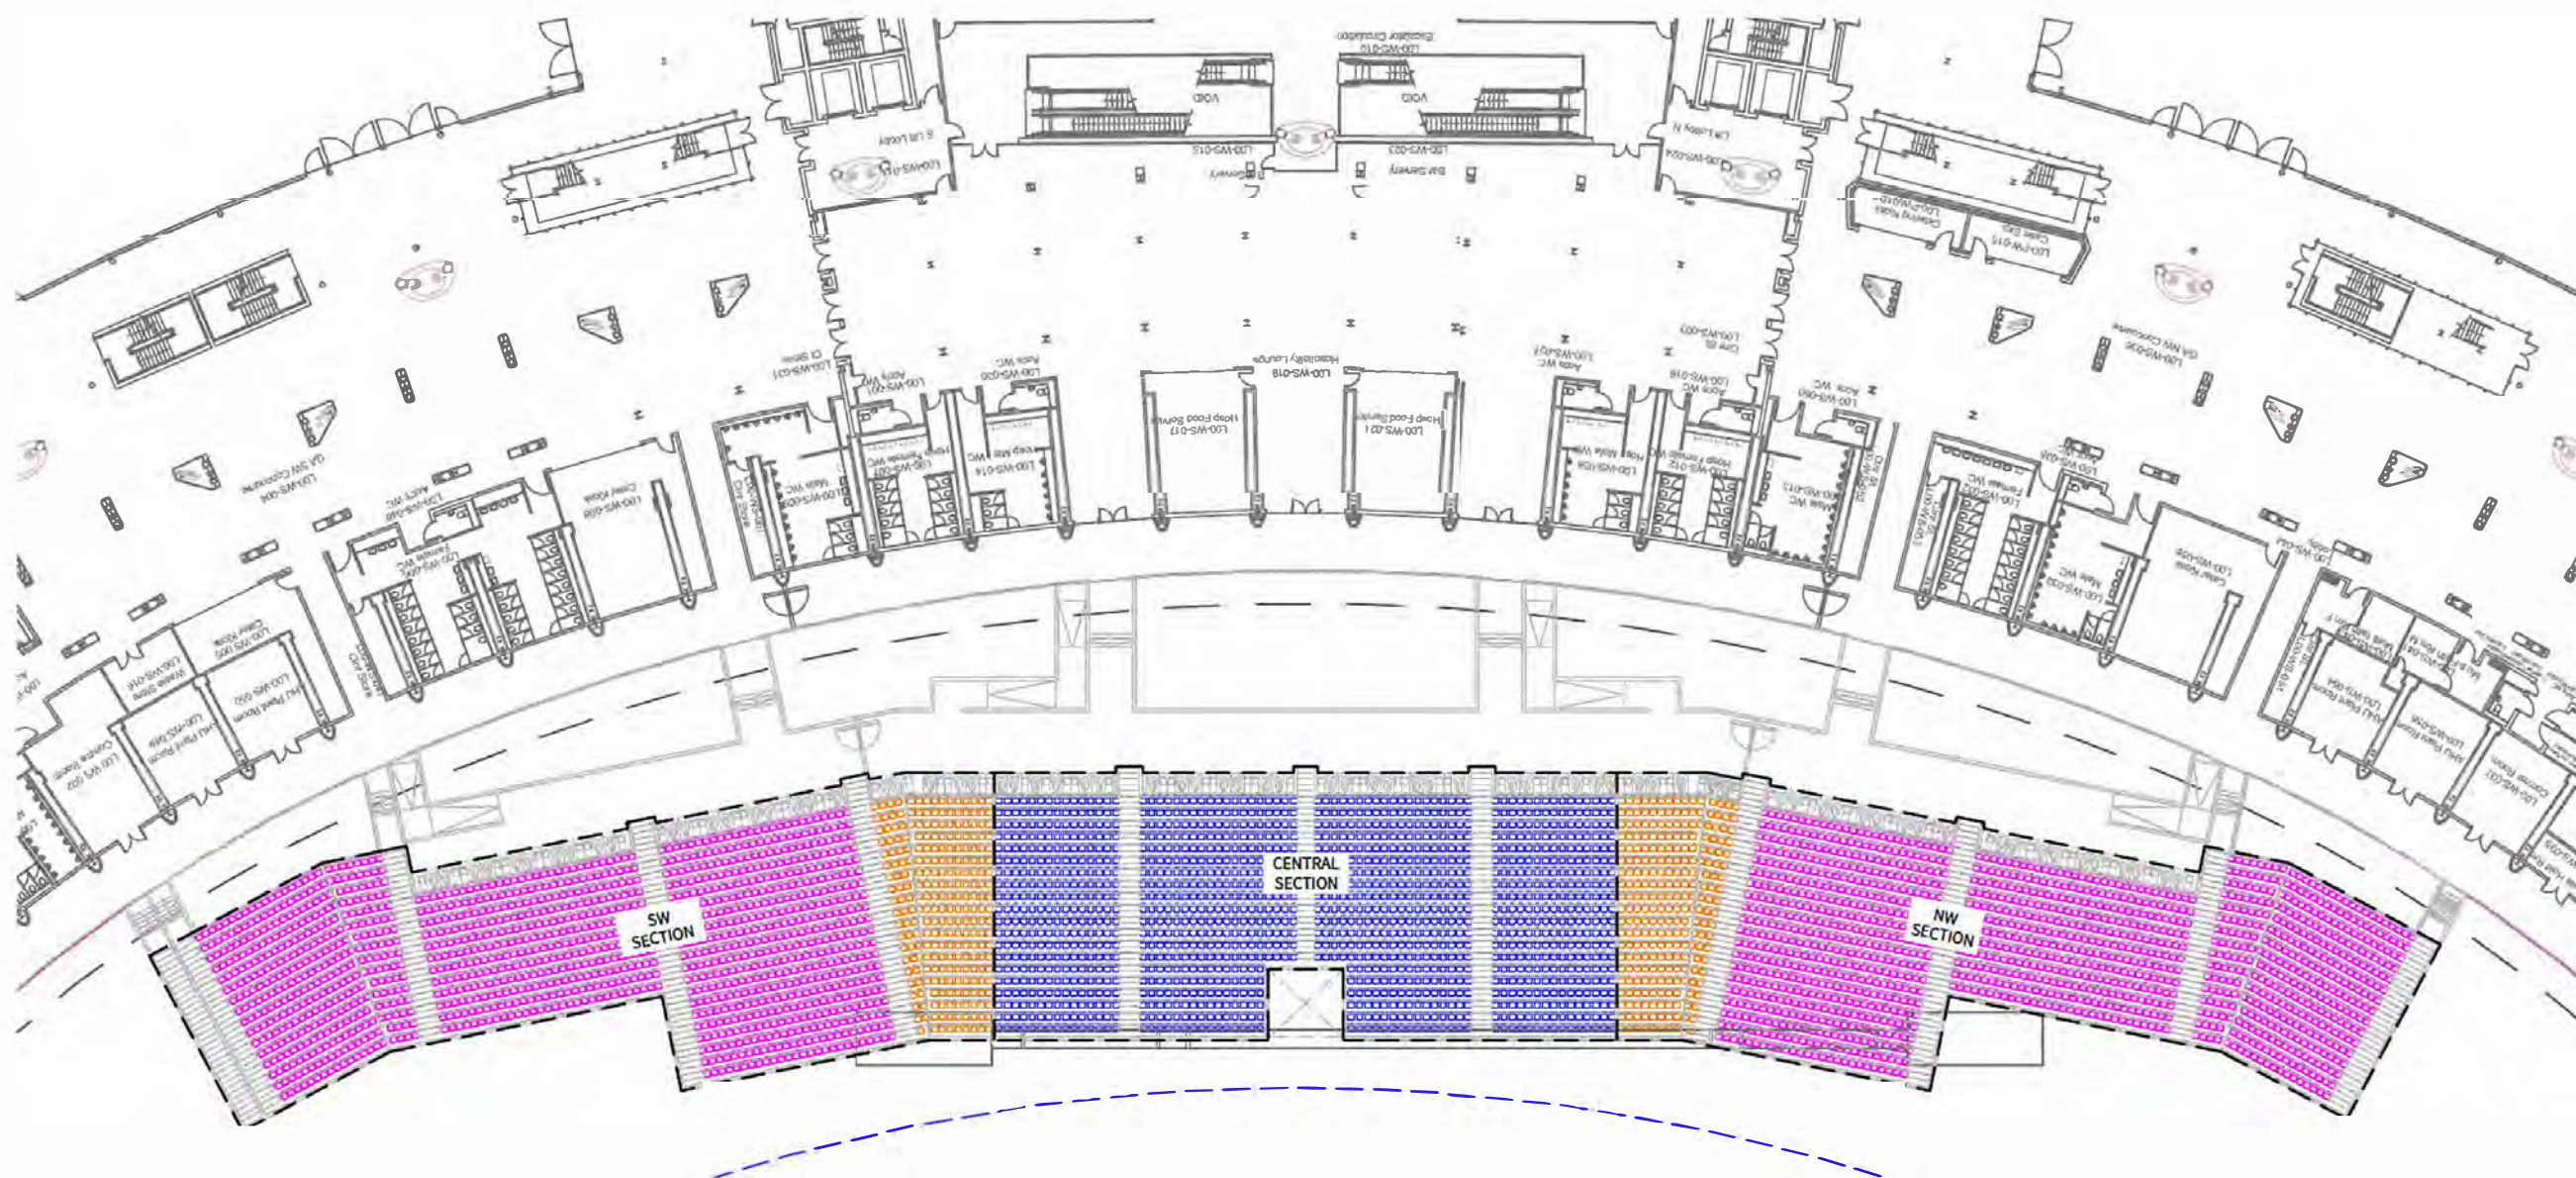

P06	STANDS REMOVED FROM VIEW	RK	AP	17.08.22
P05	RESTRICTED VIEW SEATING REMOVED	RK	AP	17.06.22
P04	DIMENSIONS ADDED	RK	AP	12.05.22
P03	ARCHITECTURE REVISED TO LATEST	TO	JT	14.03.22
P02	SEATING + ROW NUMBERS UPDATED	YA	TD	01.03.22
P01	FIRST ISSUE	YA	TD	08.02.22

For information relating to Use, Cleaning and Maintenance see the Health and Safety File. It is assumed that all works will be carried out by a competent contractor working, where appropriate, to an approved method statement.

CLIENT: PREPARED BY ES GLOBAL ON BEHALF OF E20 STADIUM LLP

PROJECT TITLE: WEST STAND REPLACEMENT LONDON STADIUM

DRAWING TITLE: ATHLETICS CONFIGURATION - BLOCK DEFINITION GENERAL ARRANGEMENT

DATE	SCALE	PAPER SIZE	SUITABILITY
02.02.22	1:500	A3	S4

ISSUE STATUS	APPROVED BY
CONSTRUCTION	TO

DRAWING NO	REVISION
A2333-ESG-00-B1-GA-W-0201-P06_1	P06

NOTE:
 ARRANGEMENT SHOWN PRODUCED FOR ILLUSTRATION/QUOTATION PURPOSES ONLY.
 (THIS ARRANGEMENT HAS NOT BEEN ENGINEERED AND IS THUS SUBJECT TO POSSIBLE CHANGES)




ES Global Ltd.
 Unit G East, Coate House, 1-3 Coate Street, London E2 9AG
 T: +44 (0)20 7055 7200 F: +44 (0)20 7055 7201
 E: info@esglobalsolutions.com
 W: esglobalsolutions.com

1. This drawing is copyright and the property of ES Global Ltd. It must not be copied or used, in part or whole, without their written consent. Failure to do so may lead to legal proceedings under the copyright, Design and Patent Act 1988.
 2. The information shown on this drawing is based upon information supplied to ES Global Ltd. by the client.
 It is the responsibility of the client to:
 (i) check that their requirements have been correctly interpreted,
 (ii) confirm the receipt and the validity of the drawing contents in writing to the issuing office ES Global Ltd.
 3. Any modification to the details shown on this drawing MUST be referred to ES Global Ltd. for their information and approval.
 4. All dimensions in MILLIMETRES - unless noted otherwise.

NOTES

- GENERAL ADMISSION SEATING
- MAIN HOSPITALITY SEATING
- PREMIUM GA SEATING
- DUGOUT SEATING
- DISABLED SEATING

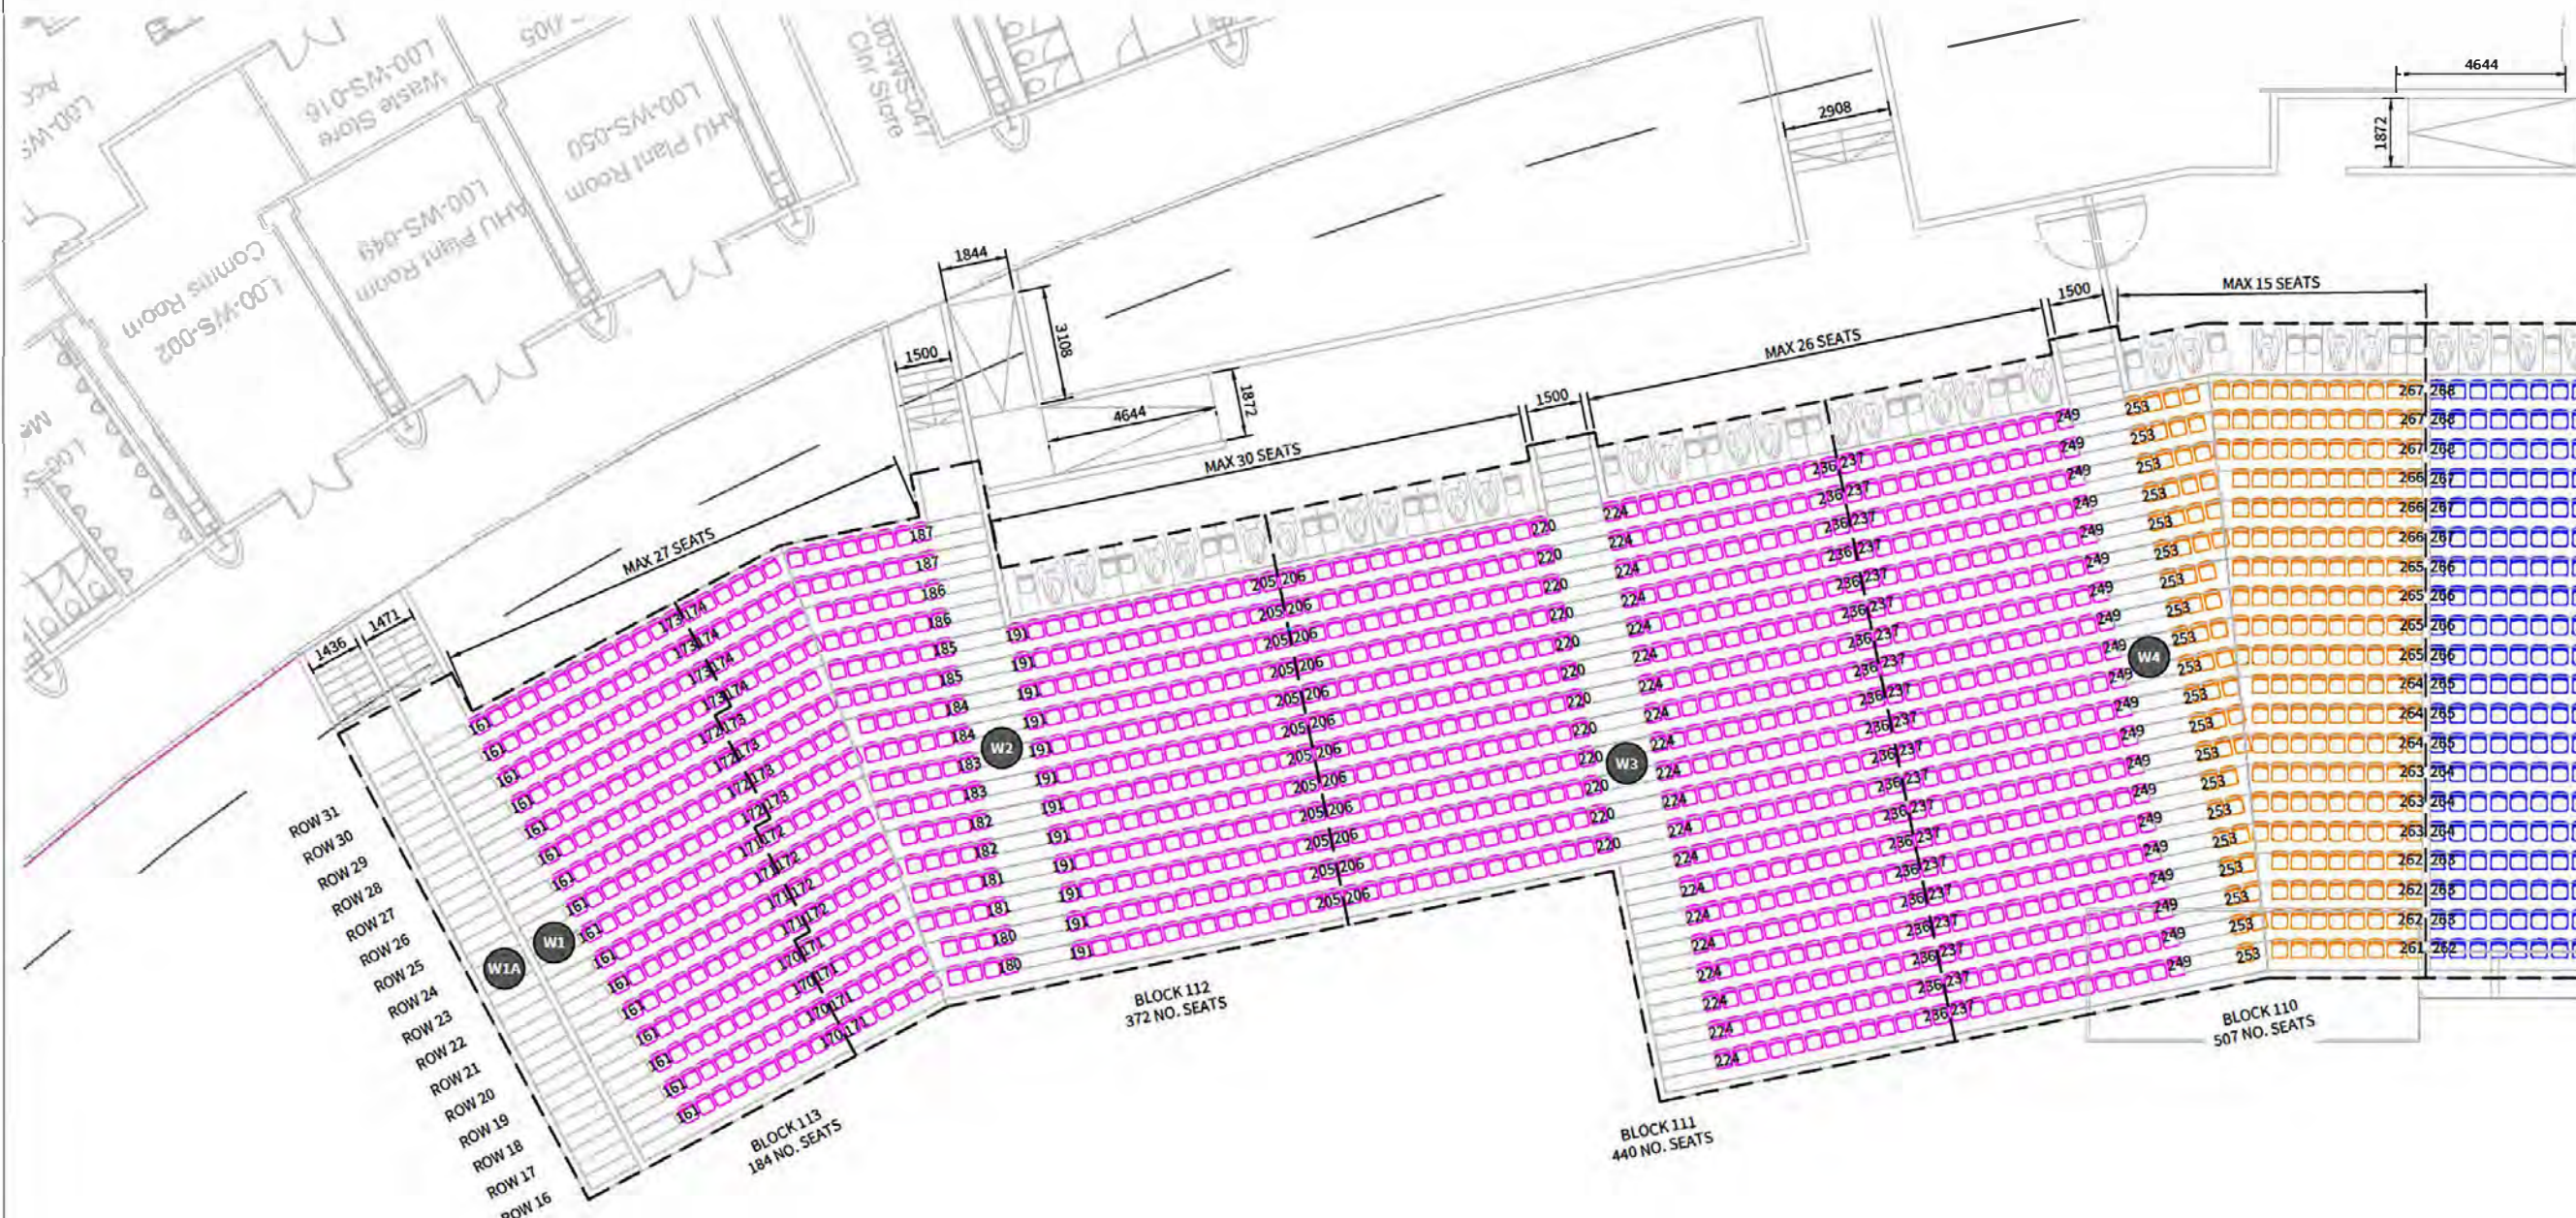

P06	STANDS REMOVED FROM VIEW	RK	AP	17.08.22
P05	RESTRICTED VIEW SEATING REMOVED	RK	AP	17.08.22
P04	DIMENSIONS ADDED	RK	AP	12.05.22
P03	ARCHITECTURE REVISED TO LATEST	TO	JT	14.03.22
P02	SEATING + ROW NUMBERS UPDATED	YA	TD	01.03.22
P01	FIRST ISSUE	YA	TD	08.02.22

For information relating to Use, Clearing and Maintenance see the Health and Safety File. It is assumed that all works will be carried out by a competent contractor working, where appropriate, to an approved method statement.

CLIENT
 PREPARED BY ES GLOBAL ON BEHALF OF E20 STADIUM LLP

PROJECT TITLE
 WEST STAND REPLACEMENT
 LONDON STADIUM
 DRAWING TITLE
 ATHLETICS CONFIGURATION - SOUTH WEST
 SECTION BLOCK 110-113

DATE	SCALE	PAPER SIZE	SUITABILITY
02.02.22	1:200	A3	S4
ISSUE STATUS	CONSTRUCTION		APPROVED BY TO
DRAWING NO	A2333-ESG-00-B1-GA-W-0201-POS_2		REVISION P06


NOTE:
ARRANGEMENT SHOWN PRODUCED FOR ILLUSTRATION/QUOTATION PURPOSES ONLY.
(THIS ARRANGEMENT HAS NOT BEEN ENGINEERED AND IS THUS SUBJECT TO POSSIBLE CHANGES)



ES Global Ltd.
Unit G East, Coate House, 1-3 Coate Street, London E2 9AG
T: +44 (0)20 7055 7200 F: +44 (0)20 7055 7201
E: info@esglobalsolutions.com
W: esglobalsolutions.com

1. This drawing is copyright and the property of ES Global Ltd. It must not be copied or used, in part or whole, without their written consent. Failure to do so may lead to legal proceedings under the Copyright, Design and Patent Act 1988.
2. The information shown on this drawing is based upon information supplied to ES Global Ltd. by the client.
It is the responsibility of the client to:
(i) check that their requirements have been correctly interpreted.
(ii) confirm the receipt and the validity of the drawing contents in writing to the issuing office ES Global Ltd.
3. Any modification to the details shown on this drawing MUST be referred to ES Global Ltd. for their information and approval.
4. All dimensions in MILLIMETRES - unless noted otherwise.
5. Do NOT scale from this drawing. Stick only to figured dimensions.

- NOTES
- GENERAL ADMISSION SEATING
 - MAIN HOSPITALITY SEATING
 - PREMIUM GA SEATING
 - DUGOUT SEATING
 - DISABLED SEATING

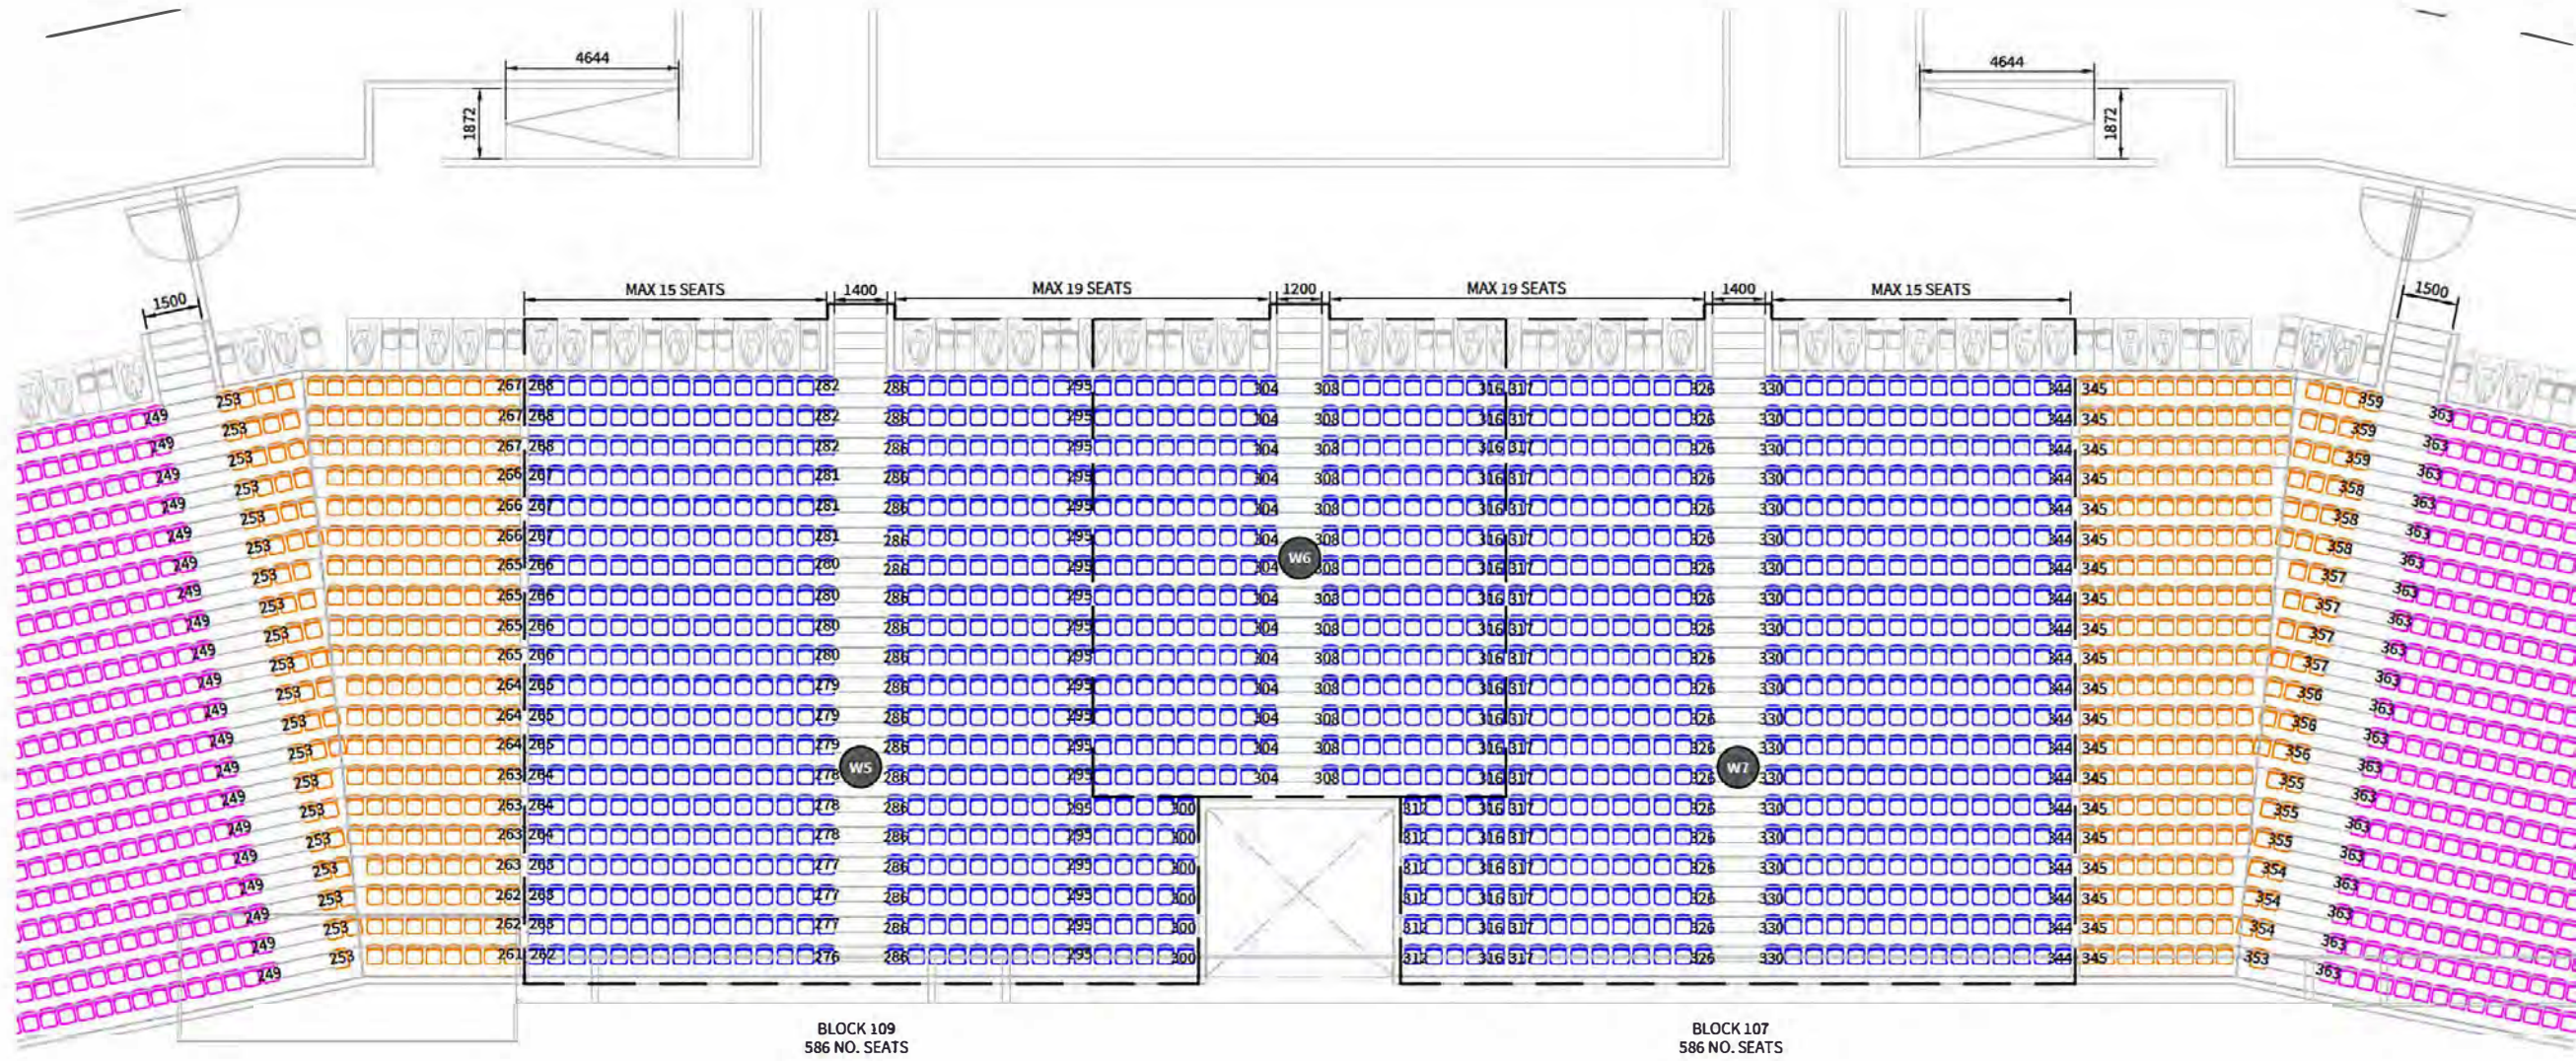

P06	STANDS REMOVED FROM VIEW	RK	AP	17.06.22
P05	RESTRICTED VIEW SEATING REMOVED	RK	AP	17.06.22
P04	DIMENSIONS ADDED	RK	AP	12.05.22
P03	ARCHITECTURE REVISED TO LATEST	TO	JT	14.03.22
P02	SEATING - ROW NUMBERS UPDATED	YA	TD	01.03.22
P01	FIRST ISSUE	YA	TD	08.02.22

REV	DESCRIPTION	DRAWN	CHK'D	DATE
-----	-------------	-------	-------	------

For information relating to Use, Clearing and Maintenance see the Health and Safety File. It is assumed that all works will be carried out by a competent contractor working, where appropriate, to an approved method statement.

CLIENT
PREPARED BY ES GLOBAL ON BEHALF OF E20 STADIUM LLP

PROJECT TITLE
WEST STAND REPLACEMENT
LONDON STADIUM

DRAWING TITLE
FOOTBALL CONFIGURATION - CENTRAL SECTION
BLOCK 107-109

DATE	SCALE	PAPER SIZE	SUITABILITY
28.01.22	1:200	A3	S4

ISSUE STATUS	APPROVED BY
CONSTRUCTION	TO

DRAWING NO	REVISION
A2333-ESG-00-B1-GA-W-0201-P06_3	P06

NOTE:
ARRANGEMENT SHOWN PRODUCED FOR ILLUSTRATION/QUOTATION PURPOSES ONLY.
(THIS ARRANGEMENT HAS NOT BEEN ENGINEERED AND IS THUS SUBJECT TO POSSIBLE CHANGES)



ES Global Ltd.
Unit G East, Coate House, 1-3 Coate Street, London E2 9AG
T. +44 (0)20 7055 7200 F. +44 (0)20 7055 7201
E. info@esglobalsolutions.com
W. esglobalsolutions.com

1. This drawing is copyright and the property of ES Global Ltd. It must not be copied or used, in part or whole, without their written consent. Failure to do so may lead to legal proceedings under the copyright, Design and Patents Act 1988.
2. The information shown on this drawing is based upon information supplied to ES Global Ltd. by the client. It is the responsibility of the client to check that their requirements have been correctly interpreted, (ii) confirm the receipt and the validity of the drawing, (iii) writing to the issuing office ES Global Ltd.
3. Any modifications to the details shown on this drawing MUST be referred to ES Global Ltd. for their information and approval.
4. All dimensions in MILLIMETRES - unless noted otherwise.
5. Do NOT scale from this drawing. Trust only to figured dimensions.

NOTES

- GENERAL ADMISSION SEATING
- MAIN HOSPITALITY SEATING
- PREMIUM GA SEATING
- DUGOUT SEATING
- DISABLED SEATING



P06	STANDS REMOVED FROM VIEW	RK	AP	17.06.22
P05	RESTRICTED VIEW SEATING REMOVED	RK	AP	17.06.22
P04	DIMENSIONS ADDED	RK	AP	12.05.22
P03	ARCHITECTURE REVISED TO LATEST	TO	JT	14.02.22
P02	SEATING + ROW NUMBERS UPDATED	YA	TO	01.03.22
P01	FIRST ISSUE	YA	TO	08.02.22

REV	DESCRIPTION	DRAWN	CHK'D	DATE
-----	-------------	-------	-------	------

For information relating to Use, Cleaning and Maintenance see the Health and Safety File. It is assumed that all works will be carried out by a competent contractor working, where appropriate, to an approved method statement.

CLIENT: PREPARED BY ES GLOBAL ON BEHALF OF E20 STADIUM LLP

PROJECT TITLE: WEST STAND REPLACEMENT LONDON STADIUM

DRAWING TITLE: ATHLETICS CONFIGURATION - NORTHWEST SECTION BLOCK 103-106

DATE	SCALE	PAPER SIZE	SUITABILITY
02.02.22	1:200	A3	S4

ISSUE STATUS	APPROVED BY
CONSTRUCTION	TO

DRAWING NO	REVISION
A2333-ESG-00-B1-GA-W-0201-P06_4	P06


NOTE:
ARRANGEMENT SHOWN PRODUCED FOR ILLUSTRATION/QUOTATION PURPOSES ONLY.
(THIS ARRANGEMENT HAS NOT BEEN ENGINEERED AND IS THUS SUBJECT TO POSSIBLE CHANGES)



ES Global Ltd.
Unit G East, Coate House, 1-3 Coate Street, London E9 6AG
T. +44 (0)20 7055 7200 F. +44 (0)20 7055 7201
E. info@esglobalsolutions.com
W. esglobalsolutions.com

1. This drawing is copyright and the property of ES Global Ltd. It must NOT be copied or used, in part or whole, without their written consent. Failure to do so may lead to legal proceedings under the Copyright, Designs and Patents Act 1988.
2. The information shown on this drawing is based upon information supplied to ES Global Ltd. by the client.
It is the responsibility of the client to:
(i) check that their requirements have been correctly interpreted.
(ii) confirm the receipt and the validity of the drawing contents in writing to the issuing office ES Global Ltd.
3. Any modification to the details shown on this drawing MUST be referred to ES Global Ltd. for their information and approval.
4. All dimensions in MILLIMETRES - unless noted otherwise.
5. Do NOT scale from this drawing. Work only to figured dimensions.

- NOTES
- GENERAL ADMISSION SEATING
 - MAIN HOSPITALITY SEATING
 - PREMIUM GA SEATING
 - DUGOUT SEATING
 - DISABLED SEATING

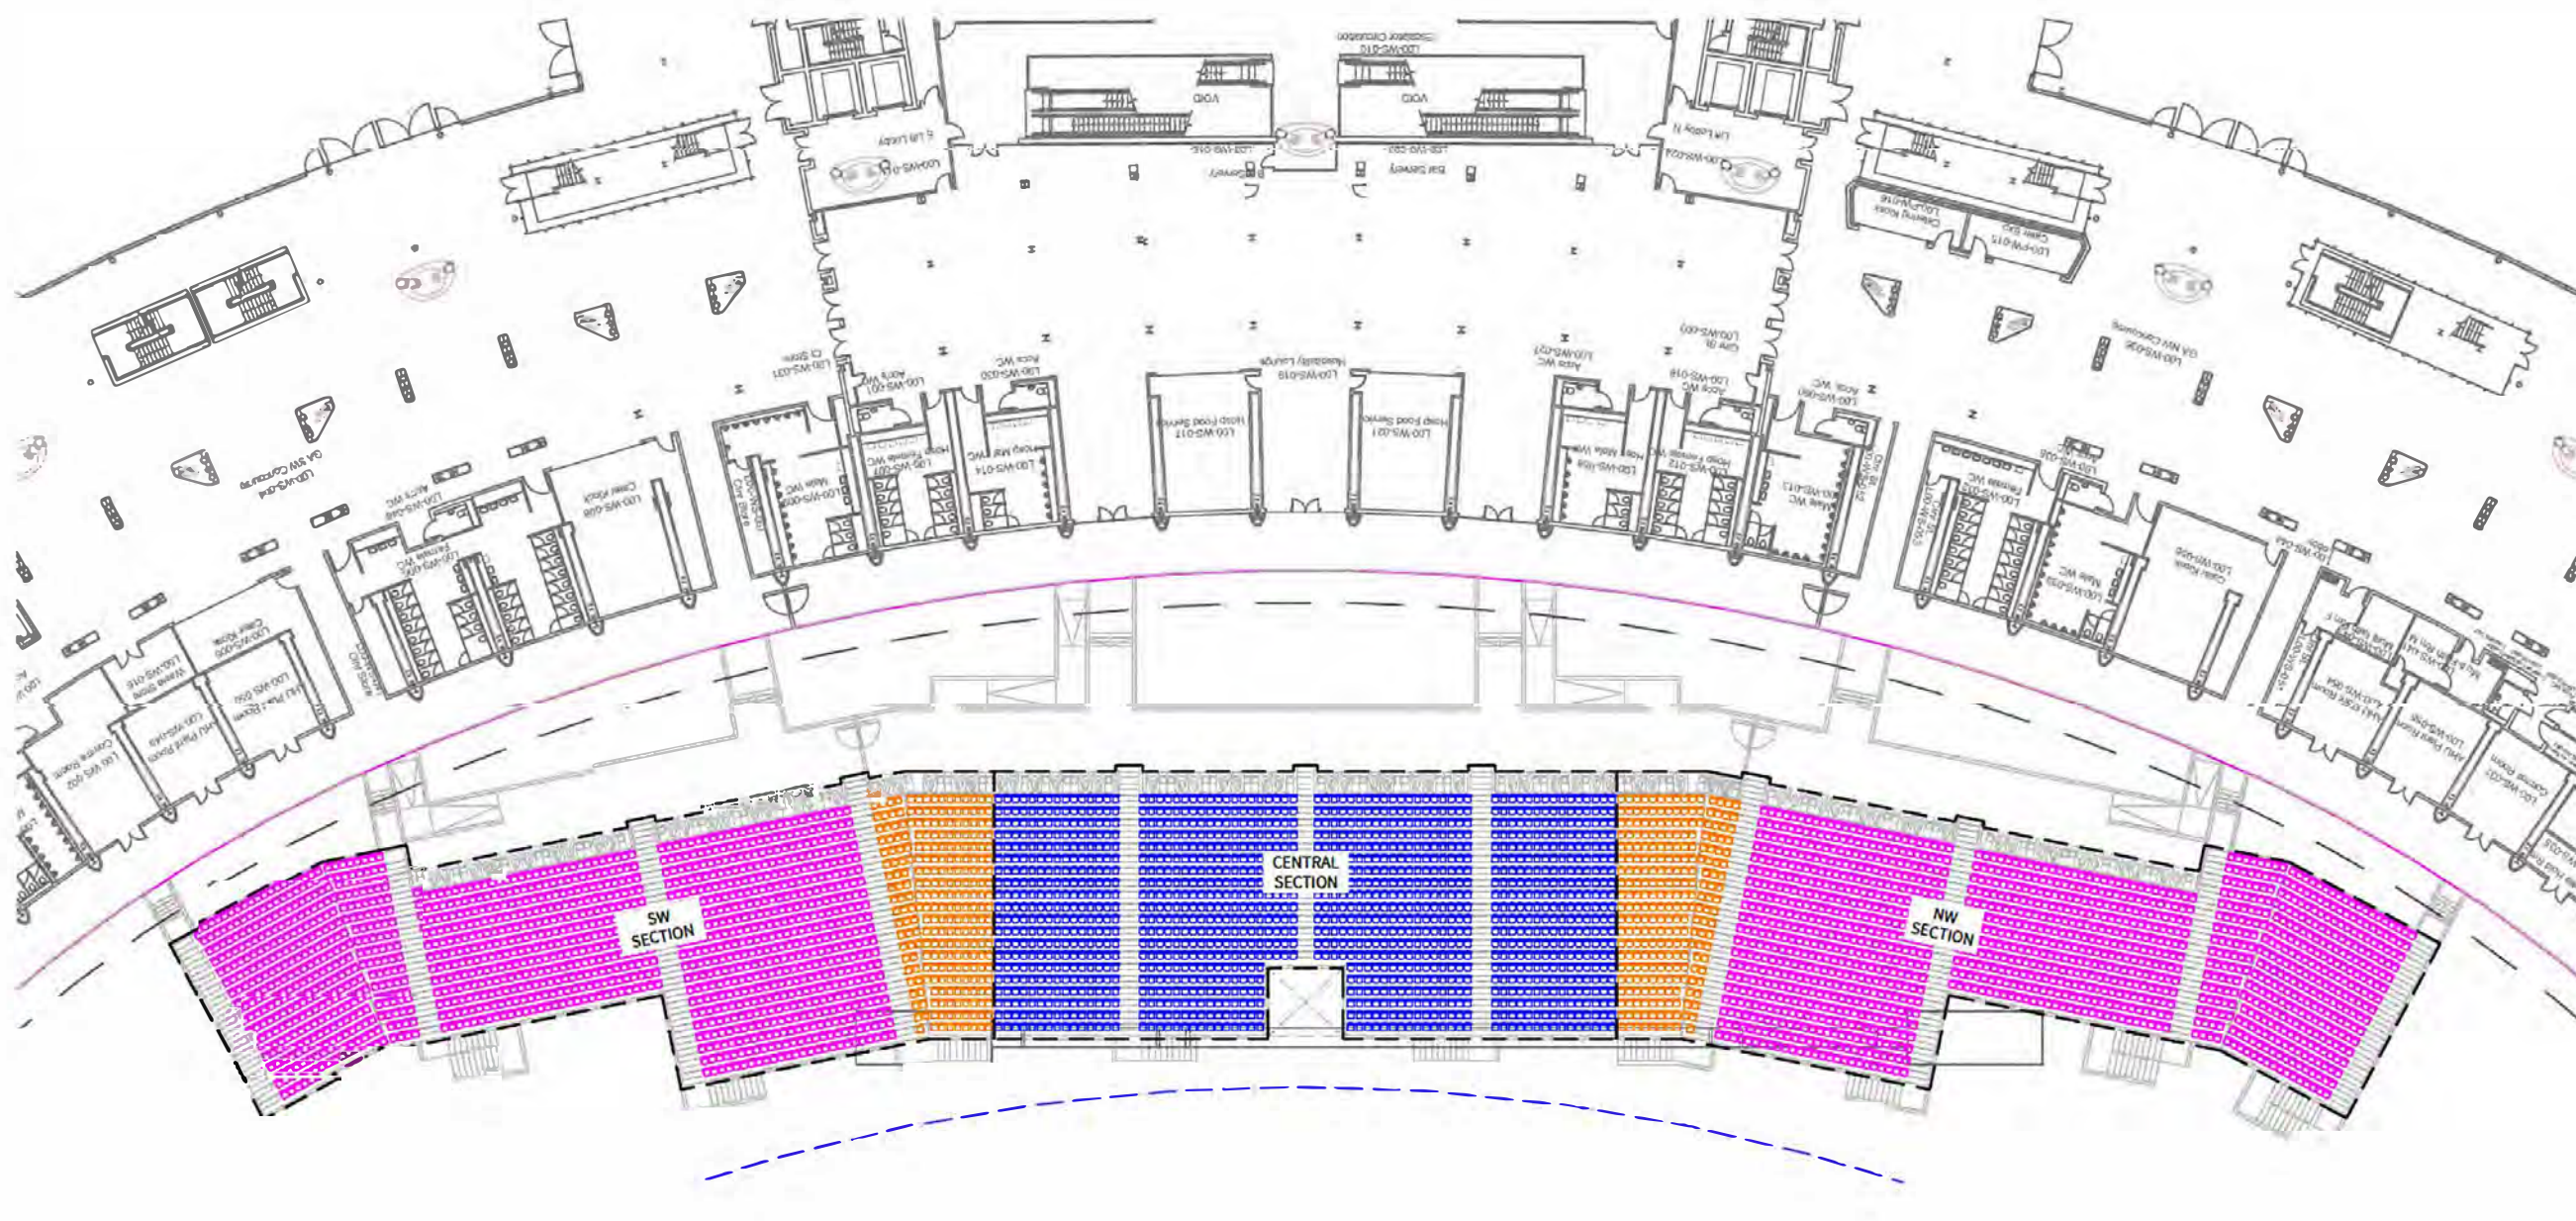

P05	RESTRICTED VIEW SEATS REMOVED	RR	AP	17.08.22
P04	DIMENSIONS ADDED	RR	AP	12.05.22
P03	ARCHITECTURE REVISED TO LATEST	TO	JT	14.03.22
P02	SEATING + ROW NUMBERS UPDATED	YA	TD	01.03.22
P01	FIRST ISSUE	YA	TD	08.02.22

REV DESCRIPTION DRAWN CHECKED DATE
For information relating to Use, Cleaning and Maintenance see the Health and Safety File. It is assumed that all works will be carried out by a competent contractor working, where appropriate, to an approved method statement.

CLIENT
PREPARED BY ES GLOBAL ON BEHALF OF E20 STADIUM LLP

PROJECT TITLE
WEST STAND REPLACEMENT
LONDON STADIUM
DRAWING TITLE
CONCERT CONFIGURATION - BLOCK DEFINITION
GENERAL ARRANGEMENT

DATE	SCALE	PAPER SIZE	SUITABILITY
02.02.22	1:500	A3	S4

ISSUE STATUS	APPROVED BY
CONSTRUCTION	TO

DRAWING NO	REVISION
A2333-ESG-00-B1-GA-W-0301-P05_1	P05


NOTE:
ARRANGEMENT SHOWN PRODUCED FOR ILLUSTRATION/QUOTATION PURPOSES ONLY.
THIS ARRANGEMENT HAS NOT BEEN ENGINEERED AND IS THUS SUBJECT TO POSSIBLE CHANGES)



ES Global Ltd.
Unit G East, Coate House, 1-3 Coate Street, London E2 9AG
T: +44 (0)20 7055 7200 F: +44 (0)20 7055 7201
E: info@esglobalsolutions.com
W: esglobalsolutions.com

1. This drawing is copyright and the property of ES Global Ltd. It must not be copied, reproduced, or used in any way without the written consent of ES Global Ltd. Failure to do so may lead to legal proceedings under the Copyright, Design and Patents Act 1988.
2. The information shown on this drawing is based upon information supplied to ES Global Ltd. by the client.
3. It is the responsibility of the client to:
(i) check that their requirements have been correctly interpreted.
(ii) confirm the receipt and the validity of the drawing contents in writing to the issuing office ES Global Ltd.
4. Any modification to the details shown on this drawing MUST be referred to ES Global Ltd. for their information and approval.
5. All dimensions in MILLIMETRES - unless noted otherwise.
6. Do NOT scale from this drawing. Trust only to figured dimension.

- NOTES
- GENERAL ADMISSION SEATING
 - MAIN HOSPITALITY SEATING
 - PREMIUM GA SEATING
 - DUGOUT SEATING
 - DISABLED SEATING

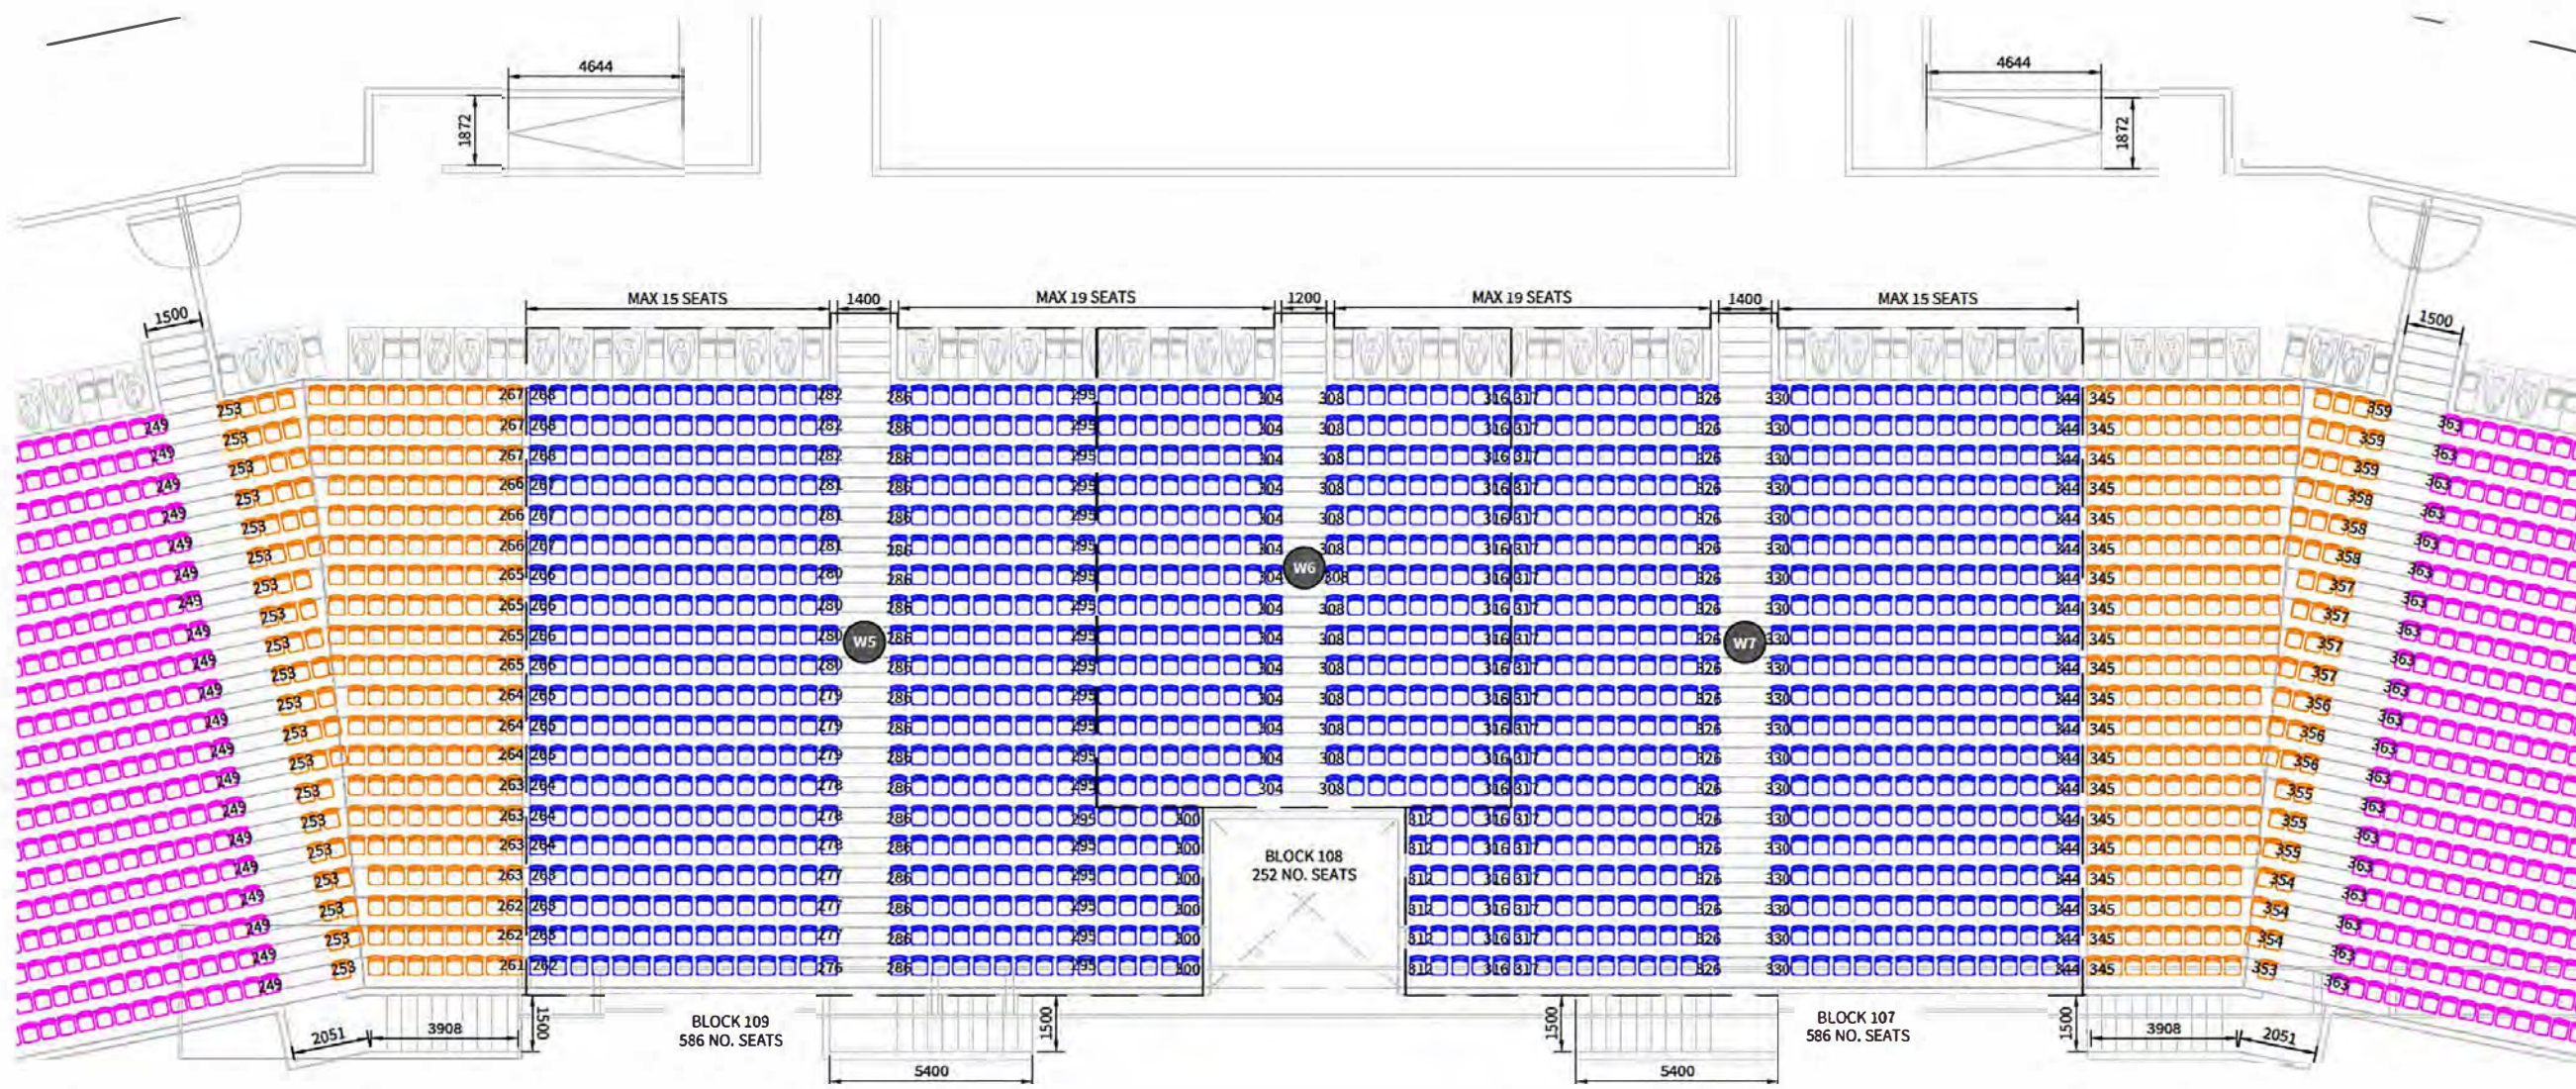

REV	DESCRIPTION	DRAWN	CHKD	DATE
P05	RESTRICTED VIEW SEATS REMOVED	RK	AP	17.06.22
P04	DIMENSIONS ADDED	RK	AP	12.05.22
P03	ARCHITECTURE REVISED TO LATEST	TO	JT	14.03.22
P02	SEATING - ROW NUMBERS UPDATED	YA	TO	01.03.22
P01	FIRST ISSUE	YA	TO	08.02.22

For information relating to Use, Cleaning and Maintenance see the Health and Safety File. It is assumed that all works will be carried out by a competent contractor working, where appropriate, to an approved method statement.

CLIENT
PREPARED BY ESG GLOBAL ON BEHALF OF E2O STADIUM LLP

PROJECT TITLE
WEST STAND REPLACEMENT
LONDON STADIUM
DRAWING TITLE
CONCERT CONFIGURATION - CENTRAL SECTION
BLOCK 107-109

DATE	SCALE	PAPER SIZE	SUITABILITY
28.01.22	1:200	A3	S4

ISSUE STATUS
CONSTRUCTION
NOT TO BE USED FOR CONSTRUCTION

APPROVED BY
TO

DRAWING NO
A2333-ESG-00-B1-GA-W-0301-P05_3

REVISION
P05


NOTE:
ARRANGEMENT SHOWN PRODUCED FOR ILLUSTRATION/QUOTATION PURPOSES ONLY.
(THIS ARRANGEMENT HAS NOT BEEN ENGINEERED AND IS THUS SUBJECT TO POSSIBLE CHANGES)



ES Global Ltd.
Unit G East, Coate House, 1-3 Coate Street, London E2 9AG
T. +44 (0)20 7055 7200 F. +44 (0)20 7055 7201
E. info@esglobalsolutions.com
W. esglobalsolutions.com

1. This drawing is copyright and the property of ES Global Ltd. It must NOT be copied or used, in part or whole, without their written consent. Failure to do so may lead to legal proceedings under the Copyright, Designs and Patents Act 1988.
2. The information shown on this drawing is based upon information supplied to ES Global Ltd. by the client. It is the responsibility of the client to:
(a) check that their requirements have been correctly interpreted.
(b) confirm the receipt and the validity of the drawing contents in writing to the issuing office ES Global Ltd.
3. Any modification to the details shown on this drawing MUST be referred to ES Global Ltd. for their information and approval.
4. All dimensions in MILLIMETRES - unless noted otherwise.
5. Do NOT scale from this drawing. Work only to figured dimensions.

- NOTES
- GENERAL ADMISSION SEATING
 - MAIN HOSPITALITY SEATING
 - PREMIUM GA SEATING
 - DUGOUT SEATING
 - DISABLED SEATING

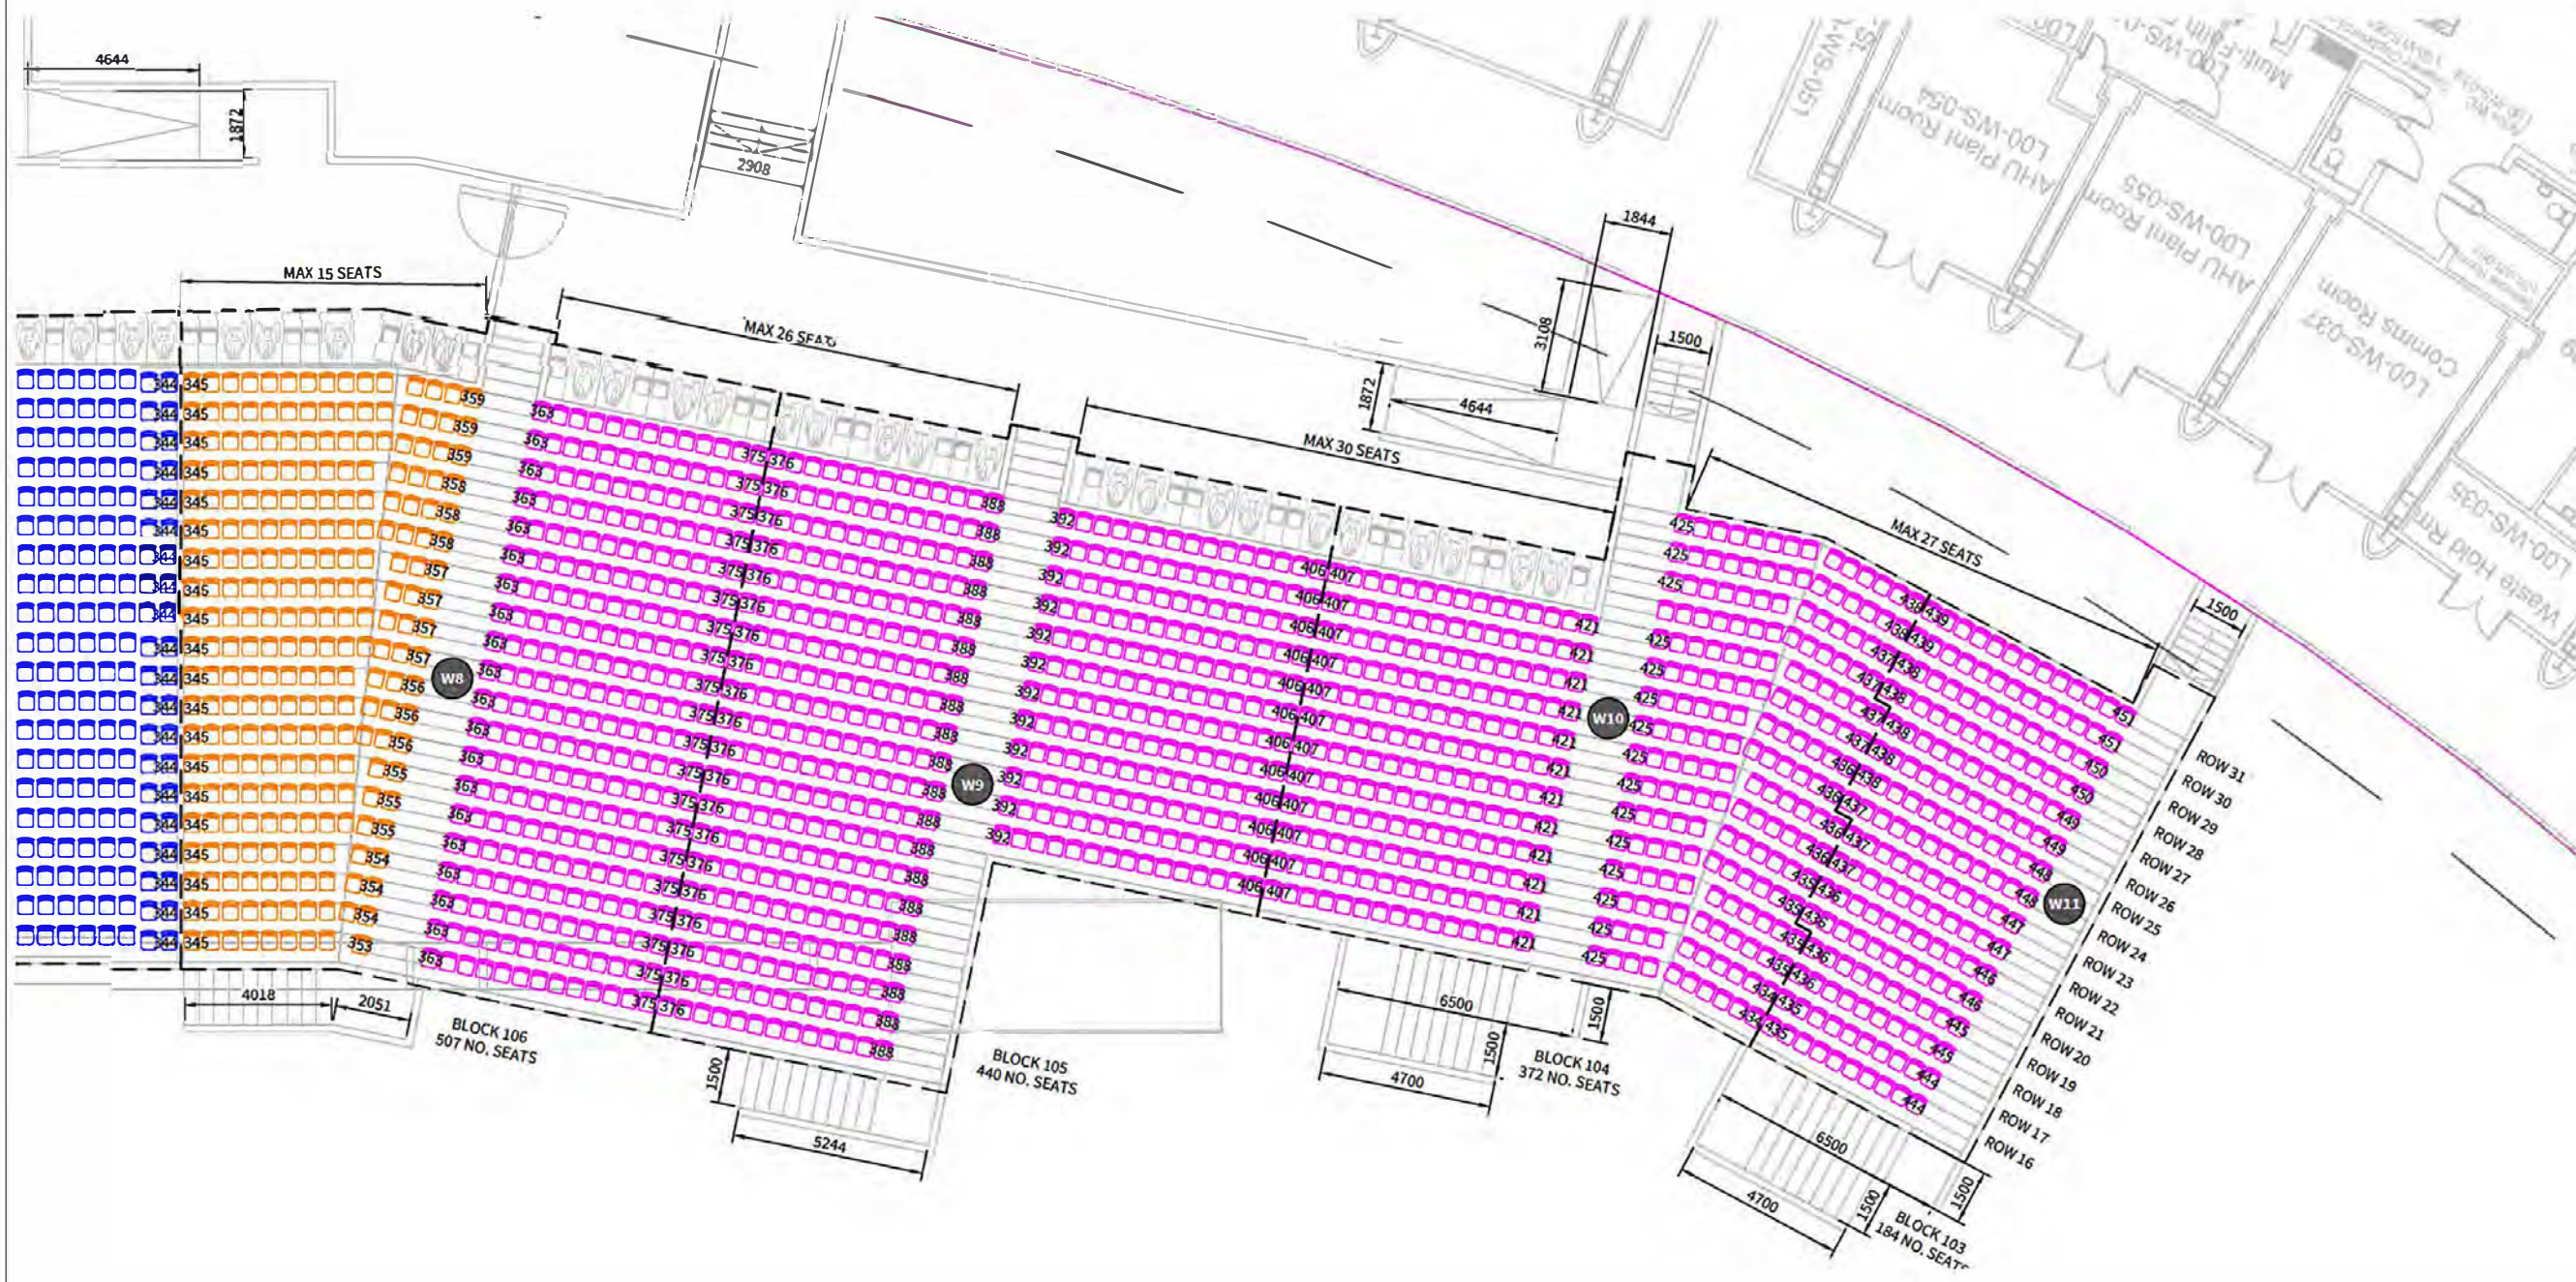

P05	RESTRICTED VIEW SEATS REMOVED	RK	AP	17.06.22
P04	DIMENSIONS ADDED	RK	AP	12.05.22
P03	ARCHITECTURE REVISED TO LATEST	TO	JT	14.03.22
P02	SEATING + ROW NUMBERS UPDATED	YA	TD	01.03.22
P01	FIRST ISSUE	YA	TD	08.02.22

For information relating to Use, Cleaning and Maintenance see the Health and Safety File. It is assumed that all works will be carried out by a competent contractor working, where appropriate, to an approved method statement.

CLIENT PREPARED BY ES GLOBAL, ON BEHALF OF E20 STADIUM LLP

PROJECT TITLE
WEST STAND REPLACEMENT
LONDON STADIUM

DRAWING TITLE
CONCERT CONFIGURATION - NORTHWEST
SECTION BLOCK 103-106

DATE	SCALE	PAPER SIZE	SUITABILITY
02.02.22	1:200	A3	S4

ISSUE STATUS
CONSTRUCTION
NOT TO BE USED FOR CONSTRUCTION

APPROVED BY
TO

DRAWING NO	REVISION
A2333-ESG-00-B1-GA-W-0301-P05_4	P05